


1 LOCATION OF WATER WELL: County: **Morris** Fraction: **NW 1/4 NE 1/4 NW 1/4** Section Number: **24** Township Number: **T 16 S** Range Number: **R 6 EW**

Distance and direction from nearest town or city street address of well if located within city?
1 mile North & 2 3/4 mile west of Wilsey

2 WATER WELL OWNER: **Dale Scott**
 RR#, St. Address, Box #: **RE 1**
 City, State, ZIP Code: **White City, Ks 66872**
 Board of Agriculture, Division of Water Resources
 Application Number:

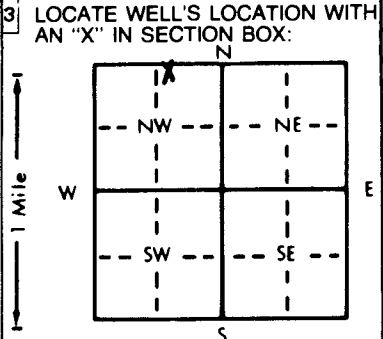

4 DEPTH OF COMPLETED WELL: **96** ft. ELEVATION: ft.
 Depth(s) Groundwater Encountered 1. **74** ft. 2. ft. 3. ft.
 WELL'S STATIC WATER LEVEL: **74** ft. below land surface measured on mo/day/yr **Aug 8 91**
 Pump test data: Well water was ft. after hours pumping gpm
 Est. Yield **13** gpm: Well water was ft. after hours pumping gpm
 Bore Hole Diameter: **8 5/8** in. to **27** ft., and **6 1/4** in. to **96** ft.
 WELL WATER TO BE USED AS:
 1 Domestic 3 Feedlot 6 Oil field water supply 9 Dewatering 12 Other (Specify below)
 2 Irrigation 4 Industrial 7 Lawn and garden only 10 Monitoring well
 Was a chemical/bacteriological sample submitted to Department? Yes..... No ; If yes, mo/day/yr sample was submitted
 Water Well Disinfected? Yes No

5 TYPE OF BLANK CASING USED:
 1 Steel 3 RMP (SR) 6 Asbestos-Cement 9 Other (specify below) Welded
 2 PVC 4 ABS 7 Fiberglass Threaded
 Blank casing diameter: **5** in. to ft., Dia. in. to ft., Dia. in. to ft.
 Casing height above land surface: **18** in., weight lbs./ft. Wall thickness or gauge No. **SDR-26**
 TYPE OF SCREEN OR PERFORATION MATERIAL:
 1 Steel 3 Stainless steel 5 Fiberglass 8 RMP (SR) 11 Other (specify)
 2 Brass 4 Galvanized steel 6 Concrete tile 9 ABS 12 None used (open hole)
 SCREEN OR PERFORATION OPENINGS ARE:
 1 Continuous slot 3 Mill slot 6 Wire wrapped 8 Saw cut 11 None (open hole)
 2 Louvered shutter 4 Key punched 7 Torch cut 10 Other (specify)
 SCREEN-PERFORATED INTERVALS: From **74** ft. to **96** ft., From ft. to ft.
 GRAVEL PACK INTERVALS: From **NONE** ft. to ft., From ft. to ft.

6 GROUT MATERIAL: 1 Neat cement 2 Cement grout 3 Bentonite 4 Other
 Grout Intervals: From **3** ft. to **27** ft., From ft. to ft.
 What is the nearest source of possible contamination:
 1 Septic tank 4 Lateral lines 7 Pit privy 10 Livestock pens 14 Abandoned water well
 2 Sewer lines 5 Cess pool 8 Sewage lagoon 11 Fuel storage 15 Oil well/Gas well
 3 Watertight sewer lines 6 Seepage pit 9 Feedyard 12 Fertilizer storage 16 Other (specify below)
 Direction from well? **West** **To be Plugged** How many feet? **15**

FROM	TO	LITHOLOGIC LOG	FROM	TO	PLUGGING INTERVALS
0	2	Topsoil BIK			
2	3	Clay TAN			
3	22	LIME & Shale Yel			
22	48	Red Rock			
48	57	LIME Broken & Shale Yel			
57	66	LIME Yel			
66	69	Shale Yel			
69	74	LIME Lite TAN			
74	76	Frac LIME-TAN			
76	84	LIME TAN			
84	96	Shale Gray			

7 CONTRACTOR'S OR LANDOWNER'S CERTIFICATION: This water well was (1) constructed, (2) reconstructed, or (3) plugged under my jurisdiction and was completed on (mo/day/year) **Aug 8 91** and this record is true to the best of my knowledge and belief. Kansas Water Well Contractor's License No. **218** This Water Well Record was completed on (mo/day/yr) **Aug 20 91** under the business name of **Zinn Water Well Drng** by (signature) **Joseph A. Zinn**

OFFICE USE ONLY
T
R
EW
SEC.