


1 LOCATION OF WATER WELL: County: Morris Fraction: NW 1/4 NE 1/4 SW 1/4 Section Number: 34 Township Number: T 16 S Range Number: R 6 E W

Distance and direction from nearest town or city street address of well if located within city? 3 mile East & 2 1/2 mile South of Delevan

2 WATER WELL OWNER: Vanier INC RR#: 1562 Board of Agriculture, Division of Water Resources City, State, ZIP Code: Salina, Ks 67401 Application Number:

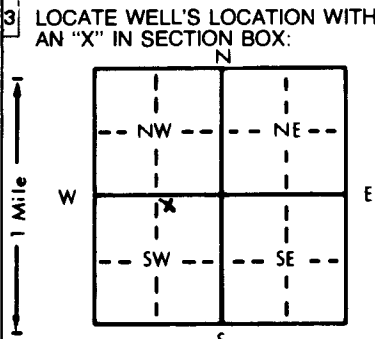

4 DEPTH OF COMPLETED WELL: 78 ft. ELEVATION: Depth(s) Groundwater Encountered: 1. Re Constructed ft. 2. WELL'S STATIC WATER LEVEL: 39 ft. below land surface measured on mo/day/yr Dec 3 92

5 TYPE OF BLANK CASING USED: 2 PVC 5 Wrought iron 8 Concrete tile CASING JOINTS: Glued X Clamped 3 RMP (SR) 6 Asbestos-Cement 9 Other (specify below) Welded 4 ABS 7 Fiberglass Threaded

TYPE OF SCREEN OR PERFORATION MATERIAL: 7 PVC 10 Asbestos-cement 1 Steel 3 Stainless steel 5 Fiberglass 8 RMP (SR) 11 Other (specify) 2 Brass 4 Galvanized steel 6 Concrete tile 9 ABS 12 None used (open hole)

6 GROUT MATERIAL: 1 Neat cement 2 Cement grout 3 Bentonite 4 Other Grout Intervals: From 3 ft. to 30 ft. What is the nearest source of possible contamination: 1 Septic tank 4 Lateral lines 7 Pit privy 10 Livestock pens 14 Abandoned water well

Table with columns: FROM, TO, LITHOLOGIC LOG, FROM, TO, PLUGGING INTERVALS. Handwritten entry: Well Reconstructed - 10" Galv Casing removed - cleaved to original and Gravel packed TO Cased with 5" PVC

7 CONTRACTOR'S OR LANDOWNER'S CERTIFICATION: This water well was (1) constructed, (2) reconstructed, or (3) plugged under my jurisdiction and was completed on (mo/day/year) Dec 3 92 and this record is true to the best of my knowledge and belief. Kansas Water Well Contractor's License No. 218 This Water Well Record was completed on (mo/day/yr) Dec 20 92 under the business name of Zinn Water Well Dring by signature Joseph A. Zinn

OFFICE USE ONLY T R E W SEC. 1/4 1/4 1/4