


1 LOCATION OF WATER WELL: County: Morris Fraction: NE 1/4 SE 1/4 SW 1/4 Section Number: 6 Township Number: T 16 S Range Number: R 6 EW

Distance and direction from nearest town or city street address of well if located within city?
2 Miles North of Delavan, KS

2 WATER WELL OWNER: U.S. Corps of Engineers
 RR#, St. Address, Box #: 700 Federal Building Board of Agriculture, Division of Water Resources
 City, State, ZIP Code: 601 E. 12th St. Kansas City, MO 64106-2895 Application Number:

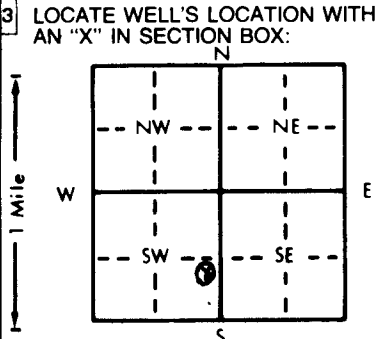

4 DEPTH OF COMPLETED WELL: 80 ft. ELEVATION:
 Depth(s) Groundwater Encountered 1. 74 ft. 2. ft. 3. ft.
 WELL'S STATIC WATER LEVEL: 39 ft. below land surface measured on mo/day/yr 1/25/95
 Pump test data: Well water was ft. after hours pumping gpm
 Est. Yield < 1 gpm: Well water was ft. after hours pumping gpm
 Bore Hole Diameter: 6 in. to 80 ft., and in. to ft.
 WELL WATER TO BE USED AS:
 5 Public water supply 8 Air conditioning 11 Injection well
 1 Domestic 3 Feedlot 6 Oil field water supply 9 Dewatering 12 Other (Specify below)
 2 Irrigation 4 Industrial 7 Lawn and garden only 10 Monitoring well
 Was a chemical/bacteriological sample submitted to Department? Yes X No; If yes, mo/day/yr sample was submitted submitted by Burns; McDannell Water Well Disinfected? Yes N/A No

5 TYPE OF BLANK CASING USED:
 1 Steel 3 RMP (SR) 5 Wrought iron 8 Concrete tile CASING JOINTS: Glued Clamped
 2 PVC 4 ABS 6 Asbestos-Cement 9 Other (specify below) Welded
 7 Fiberglass Threaded X
 Blank casing diameter: 2 in. to 70 ft., Dia. in. to ft., Dia. in. to ft.
 Casing height above land surface: 30 in., weight lbs./ft. Wall thickness or gauge No. Sched. 40

TYPE OF SCREEN OR PERFORATION MATERIAL:
 1 Steel 3 Stainless steel 5 Fiberglass 8 RMP (SR) 10 Asbestos-cement
 2 Brass 4 Galvanized steel 6 Concrete tile 9 ABS 11 Other (specify)
 12 None used (open hole)

SCREEN OR PERFORATION OPENINGS ARE:
 1 Continuous slot 3 Mill slot .010" 5 Gauzed wrapped 8 Saw cut 11 None (open hole)
 2 Louvered shutter 4 Key punched 6 Wire wrapped 9 Drilled holes
 7 Torch cut 10 Other (specify)

SCREEN-PERFORATED INTERVALS: From 70 ft. to 80 ft., From ft. to ft.
 From ft. to ft., From ft. to ft.
 GRAVEL PACK INTERVALS: From 66.5 ft. to 80 ft., From ft. to ft.
 From ft. to ft., From ft. to ft.

6 GROUT MATERIAL:
 1 Neat cement 2 Cement grout 3 Bentonite 4 Other Concrete
 Grout Intervals: From 66.5 ft. to 61.5 ft., From 61.5 ft. to 3 ft., From 3 ft. to 0 ft.
 What is the nearest source of possible contamination:
 1 Septic tank 4 Lateral lines 7 Pit privy 10 Livestock pens 14 Abandoned water well
 2 Sewer lines 5 Cess pool 8 Sewage lagoon 11 Fuel storage 15 Oil well/Gas well
 3 Watertight sewer lines 6 Seepage pit 9 Feedyard 12 Fertilizer storage 16 Other (specify below)
 13 Insecticide storage Former IOD Airfield
 Direction from well? N How many feet? 5,300

FROM	TO	LITHOLOGIC LOG	FROM	TO	PLUGGING INTERVALS
0	4	Silty black clay			
4	9	Dark yellow brown clay			
9	14	Limestone			
14	21	Grayish orange dolostone			
21	24	shale			
24	27	Limestone			
27	30	Claystone			
30	33	Limestone			
33	44	Yellow claystone			
44	47	Limestone			
47	80	Claystone			

7 CONTRACTOR'S OR LANDOWNER'S CERTIFICATION: This water well was (1) constructed, (2) reconstructed, or (3) plugged under my jurisdiction and was completed on (mo/day/year) 1/25/95 and this record is true to the best of my knowledge and belief. Kansas Water Well Contractor's License No. 555 This Water Well Record was completed on (mo/day/yr) 2/21/95 under the business name of A.W. Pool, Inc by (signature) Keith Pool

INSTRUCTIONS: Use typewriter or ball point pen. PLEASE PRESS FIRMLY and PRINT clearly. Please fill in blanks, underline or circle the correct answers. Send top three copies to Kansas Department of Health and Environment, Bureau of Water, Topeka, Kansas 66620-0001. Telephone: 913-296-5545. Send one to WATER WELL OWNER and retain one for your records.

OFFICE USE ONLY
T
R
EW
SEC.
1/4
1/4
1/4