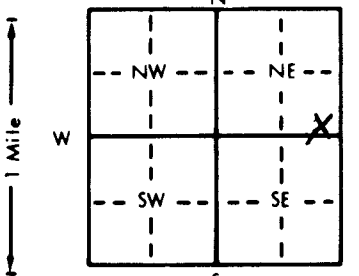


| | | | | | |
|---|--|--|-----------------------------|----------------------------------|------------------------------|
| 1 LOCATION OF WATER WELL: County: <u>Merri</u> | | Fraction <u>SE 1/4 SE 1/4 NE 1/4</u> | Section Number <u>31</u> | Township Number <u>T 16 S</u> | Range Number <u>R 7 E</u> |
| Distance and direction from nearest town or city street address of well if located within city? <u>From Wilsy Co 1 mile Wiston</u> <u>SE x GO 2 1/2 miles South</u> | | | | | |
| 2 WATER WELL OWNER: <u>RON DEAN</u> RR#, St. Address, Box #: <u>RR #1 BOX 31</u> City, State, ZIP Code: <u>Wilsy, KS 66873</u> Board of Agriculture, Division of Water Resources Application Number: | | | | | |
| 3 LOCATE WELL'S LOCATION WITH AN "X" IN SECTION BOX:  | | 4 DEPTH OF COMPLETED WELL: <u>100</u> ft. ELEVATION: Depth(s) Groundwater Encountered 1. <u>64</u> ft. 2. ft. 3. ft. WELL'S STATIC WATER LEVEL <u>60</u> ft. below land surface measured on mo/day/yr Pump test data: Well water was ft. after hours pumping gpm Est. Yield <u>6</u> gpm: Well water was ft. after hours pumping gpm Bore Hole Diameter <u>7</u> in. to ft. and in. to ft. WELL WATER TO BE USED AS: <input checked="" type="checkbox"/> 1 Domestic <input type="checkbox"/> 3 Feedlot <input type="checkbox"/> 6 Oil field water supply <input type="checkbox"/> 9 Dewatering <input type="checkbox"/> 12 Other (Specify below) <input type="checkbox"/> 2 Irrigation <input type="checkbox"/> 4 Industrial <input type="checkbox"/> 7 Lawn and garden only <input type="checkbox"/> 10 Monitoring well Was a chemical/bacteriological sample submitted to Department? Yes No: If yes, mo/day/yr sample was submitted Water Well Disinfected <input checked="" type="checkbox"/> Yes No | | | |
| 5 TYPE OF BLANK CASING USED: <input checked="" type="checkbox"/> 1 Steel <input type="checkbox"/> 3 RMP (SR) <input type="checkbox"/> 5 Wrought iron <input type="checkbox"/> 8 Concrete tile CASING JOINTS: <input type="checkbox"/> Glued <input type="checkbox"/> Clamped <input checked="" type="checkbox"/> 2 PVC <input type="checkbox"/> 4 ABS <input type="checkbox"/> 6 Asbestos-Cement <input type="checkbox"/> 9 Other (specify below) <input type="checkbox"/> Welded Blank casing diameter <u>5</u> in. to <u>80</u> ft. Dia. in. to ft. Dia. in. to ft. Dia. in. to ft. Casing height above land surface <u>2</u> in., weight <u>50</u> lbs./ft. Wall thickness or gauge No. TYPE OF SCREEN OR PERFORATION MATERIAL: <input type="checkbox"/> 1 Steel <input type="checkbox"/> 3 Stainless steel <input type="checkbox"/> 5 Fiberglass <input checked="" type="checkbox"/> 8 RMP (SR) <input type="checkbox"/> 10 Asbestos-cement <input type="checkbox"/> 2 Brass <input type="checkbox"/> 4 Galvanized steel <input type="checkbox"/> 6 Concrete tile <input type="checkbox"/> 9 ABS <input type="checkbox"/> 11 Other (specify) SCREEN OR PERFORATION OPENINGS ARE: <input type="checkbox"/> 1 Continuous slot <input checked="" type="checkbox"/> 3 Mill slot <u>25/1000</u> <input type="checkbox"/> 5 Gauzed wrapped <input type="checkbox"/> 8 Saw cut <input type="checkbox"/> 11 None (open hole) <input type="checkbox"/> 2 Louvered shutter <input type="checkbox"/> 4 Key punched <input type="checkbox"/> 6 Wire wrapped <input type="checkbox"/> 9 Drilled holes SCREEN-PERFORATED INTERVALS: From <u>80</u> ft. to ft. From ft. to ft. From ft. to ft. From ft. to ft. GRAVEL PACK INTERVALS: From <u>25</u> ft. to <u>100</u> ft. From ft. to ft. From ft. to ft. From ft. to ft. | | | | | |
| 6 GROUT MATERIAL: <input type="checkbox"/> 1 Neat cement <input type="checkbox"/> 2 Cement grout <input checked="" type="checkbox"/> 3 Bentonite <input type="checkbox"/> 4 Other Grout Intervals: From <u>0</u> ft. to <u>25</u> ft. From ft. to ft. From ft. to ft. From ft. to ft. What is the nearest source of possible contamination: <input type="checkbox"/> 1 Septic tank <input checked="" type="checkbox"/> 4 Lateral lines <input type="checkbox"/> 7 Pit privy <input type="checkbox"/> 10 Livestock pens <input type="checkbox"/> 14 Abandoned water well <input type="checkbox"/> 2 Sewer lines <input type="checkbox"/> 5 Cess pool <input type="checkbox"/> 8 Sewage lagoon <input type="checkbox"/> 11 Fuel storage <input type="checkbox"/> 15 Oil well/Gas well <input type="checkbox"/> 3 Watertight sewer lines <input type="checkbox"/> 6 Seepage pit <input type="checkbox"/> 9 Feedyard <input type="checkbox"/> 12 Fertilizer storage <input type="checkbox"/> 16 Other (specify below) Direction from well? <u>200 North</u> How many feet? <u>200</u> | | | | | |
| 7 CONTRACTOR'S OR LANDOWNER'S CERTIFICATION: This water well was (1) constructed, (2) reconstructed, or (3) plugged under my jurisdiction and was completed on (mo/day/year) <u>6/16/95</u> and this record is true to the best of my knowledge and belief. Kansas Water Well Contractor's License No. <u>451</u> This Water Well Record was completed on (mo/day/yr) <u>6/22/95</u> under the business name of <u>Holdman Well Drilling</u> by (signature) <u>Craig Holdman</u> | | | | | |