2D

WATER WELL RECORD Form WWC-5 KSA 82a-1212

1 LOCATION OF WATER WELL: County: MORRIS	Fraction: NW¼ SE ¼ NE ¼	Section Number: 29	Township Number: T 16 S	Range Number: R 7 (E)W

Distance and direction from nearest town or city street address of well if located within city? IN WILSEY, KANSAS

2 WATER WELL OWNER: CITY OF WILSEY, ATTN: JEFF FALTER

RR#, St. Address, Box # : 205 N. 7th Str.

City, State, ZIP Code : WILSEY, KANSAS, 66873

Board of Agriculture, Division of Water Resources Application Number: —

3 LOCATE WELL'S LOCATION WITH AN "X" IN SECTION BOX:

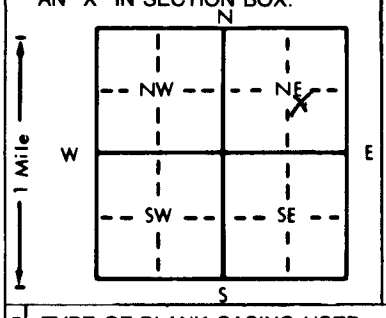

4 DEPTH OF COMPLETED WELL 70 ft. ELEVATION: —

Depth(s) Groundwater Encountered 1. 12 ft. 2. 62 ft. 3. — ft.

WELL'S STATIC WATER LEVEL 15.77 ft. below land surface measured on mo/day/yr 11/12/98

Pump test data: Well water was ... ft. after ... hours pumping ... gpm

Est. Yield — gpm: Well water was ... ft. after ... hours pumping ... gpm

Bore Hole Diameter 9 7/8 in. to 22 ft., and 6 in. to 70 ft.

WELL WATER TO BE USED AS: 1 Domestic 2 Irrigation 3 Feedlot 4 Industrial 5 Public water supply 6 Oil field water supply 7 Lawn and garden only 8 Air conditioning 9 Dewatering 10 Monitoring well 11 Injection well 12 Other (Specify below)

Was a chemical/bacteriological sample submitted to Department? Yes ... No X ; If yes, mo/day/yr sample was submitted

Water Well Disinfected? Yes No X

5 TYPE OF BLANK CASING USED: 1 Steel 2 PVC 3 RMP (SR) 4 ABS 5 Wrought iron 6 Asbestos-Cement 7 Fiberglass 8 Concrete tile 9 Other (specify below)

CASING JOINTS: Glued ... Clamped ... Welded ... Threaded X

Blank casing diameter 6 in. to 22 ft., Dia 2 in. to 50 ft., Dia — in. to — ft.

Casing height above land surface ... in., weight ... lbs./ft. Wall thickness or gauge No. ...

TYPE OF SCREEN OR PERFORATION MATERIAL: 1 Steel 2 Brass 3 Stainless steel 4 Galvanized steel 5 Fiberglass 6 Concrete tile 7 PVC 8 RMP (SR) 9 ABS 10 Asbestos-cement 11 Other (specify) ... 12 None used (open hole)

SCREEN OR PERFORATION OPENINGS ARE: 1 Continuous slot 2 Louvered shutter 3 Mill slot 4 Key punched 5 Gauzed wrapped 6 Wire wrapped 7 Torch cut 8 Saw cut 9 Drilled holes 10 Other (specify) ... 11 None (open hole)

SCREEN-PERFORATED INTERVALS: From 50 ft. to 70 ft., From — ft. to — ft.; From — ft. to — ft., From — ft. to — ft.

SAND ~~GRAVEL~~ PACK INTERVALS: From 48 ft. to 70 ft., From — ft. to — ft.; From — ft. to — ft., From — ft. to — ft.

6 GROUT MATERIAL: 1 Neat cement 2 Cement grout 3 Bentonite 4 Other ...

Grout Intervals: From ... ft. to ... ft., From ... ft. to ... ft., From ... ft. to ... ft.

What is the nearest source of possible contamination: 1 Septic tank 2 Sewer lines 3 Watertight sewer lines 4 Lateral lines 5 Cess pool 6 Seepage pit 7 Pit privy 8 Sewage lagoon 9 Feedyard 10 Livestock pens 11 Fuel storage 12 Fertilizer storage 13 Insecticide storage 14 Abandoned water well 15 Oil well/Gas well 16 Other (specify below) CONTAMINATED SITE

Direction from well? How many feet?

FROM	TO	LITHOLOGIC LOG	FROM	TO	PLUGGING INTERVALS
0	2	FILL			
2	10	CLAY, TAN TO BROWN			
10	36	SHALE, LIMESTONE, INTERBEDDED			
36	44	SHALE, GRAY			
44	46	LIMESTONE, GRAY			
46	62	SHALE, GRAY			
62	68	LIMESTONE, BLUISH GRAY			
68	70	SHALE, GRAY			
	70	TOTAL DEPTH			

7 CONTRACTOR'S OR LANDOWNER'S CERTIFICATION: This water well was (1) constructed, (2) reconstructed, or (3) plugged under my jurisdiction and was completed on (mo/day/year) 11/9/98 and this record is true to the best of my knowledge and belief. Kansas Water Well Contractor's License No. 585 This Water Well Record was completed on (mo/day/yr) 12/15/98 under the business name of AEI by (signature) [signature]

INSTRUCTIONS: Use typewriter or ball point pen. *PLEASE PRESS FIRMLY* and *PRINT* clearly. Please fill in blanks, underline or circle the correct answers. Send top three copies to Kansas Department of Health and Environment, Bureau of Water, Topeka, Kansas 66620-0001. Telephone: 913-296-5545. Send one to WATER WELL OWNER and retain one for your records.

OFFICE USE ONLY T R E/W SEC. ¼ ¼ ¼