

1 LOCATION OF WATER WELL:	Fraction	Section Number	Township Number	Range Number
County: <u>MORRIS</u>	<u>NNW 1/4 NW 1/4 NE 1/4</u>	<u>22</u>	T <u>16</u> S	R <u>7</u> <u>EN</u>

Distance and direction from nearest town or city street address of well if located within city?

1 MILE NORTH AND 1.5 MILES EAST OF WILSBY2 WATER WELL OWNER: RICK GREER

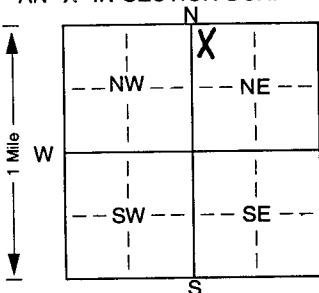
RR#, St. Address, Box # :

City, State, ZIP Code :

Board of Agriculture, Division of Water Resources

Application Number: _____

3 LOCATE WELL'S LOCATION WITH AN "X" IN SECTION BOX:

4 DEPTH OF COMPLETED WELL: 125 ft. ELEVATION: _____Depth(s) Groundwater Encountered 1. 61 ft. 2. _____ ft. 3. _____ ft.WELL'S STATIC WATER LEVEL 61 ft. below land surface measured on mo/day/yr 4/13/01

Pump test data: Well water was _____ ft. after _____ hours pumping _____ gpm

Est. Yield 5 gpm: Well water was _____ ft. after _____ hours pumping _____ gpmBore Hole Diameter 8.75 in. to 125 ft., and _____ in. to _____ ft.

WELL WATER TO BE USED AS: 5 Public water supply 8 Air conditioning 11 Injection well

1 Domestic 3 Feedlot 6 Oil field water supply 9 Dewatering 12 Other (Specify below)

2 Irrigation 4 Industrial 7 Domestic (lawn & garden) 10 Monitoring well _____

Was a chemical/bacteriological sample submitted to Department? Yes _____ No _____; If yes, mo/day/yr sample was submitted

Water Well Disinfected? Yes _____ No _____

5 TYPE OF BLANK CASING USED:

1 Steel 3 RMP (SR) 5 Wrought iron 8 Concrete tile CASING JOINTS: Glued X Clamped _____2 PVC 4 ABS 7 Fiberglass _____ Welded _____Blank casing diameter 5 in. to 65 ft., Dia 5 in. to 115 ft., Dia _____ in. to _____ ft.Casing height above land surface 18 in., weight _____ lbs./ft. Wall thickness or gauge No. SDR26

TYPE OF SCREEN OR PERFORATION MATERIAL:

1 Steel 3 Stainless steel 5 Fiberglass 8 RMP (SR) 10 Asbestos-cement

2 Brass 4 Galvanized steel 6 Concrete tile 9 ABS 11 Other (specify) _____

SCREEN OR PERFORATION OPENINGS ARE:

1 Continuous slot 3 Mill slot 5 Gauzed wrapped 8 Saw cut 11 None (open hole)

2 Louvered shutter 4 Key punched 6 Wire wrapped 9 Drilled holes 10 Other (specify) _____ ft.

SCREEN-PERFORATED INTERVALS: From 115 ft. to 125 ft., From _____ ft. to _____ ft.From 65 ft. to 75 ft., From _____ ft. to _____ ft.GRAVEL PACK INTERVALS: From 25 ft. to 125 ft., From _____ ft. to _____ ft.

From _____ ft. to _____ ft., From _____ ft. to _____ ft.

6 GROUT MATERIAL:

1 Neat cement 2 Cement grout 3 Bentonite 4 Other _____Grout Intervals: From 0 ft. to 25 ft., From _____ ft. to _____ ft., From _____ ft. to _____ ft.

What is the nearest source of possible contamination:

1 Septic tank 4 Lateral lines 7 Pit privy 10 Livestock pens 14 Abandoned water well

2 Sewer lines 5 Cess pool 8 Sewage lagoon 11 Fuel storage 15 Oil well/Gas well

3 Watertight sewer lines 6 Seepage pit 9 Feedyard 12 Fertilizer storage 16 Other (specify below) _____

Direction from well? SOUTH How many feet? 150 feet

FROM	TO	LITHOLOGIC LOG	FROM	TO	PLUGGING INTERVALS
<u>0</u>	<u>3</u>	<u>CLAY</u>	<u>109</u>	<u>123</u>	<u>SHALE Light tan</u>
<u>3</u>	<u>23</u>	<u>LIMESTONE TAN</u>	<u>123</u>	<u>125</u>	<u>LIMESTONE GRAY</u>
<u>23</u>	<u>35</u>	<u>SHALE TRINGRAPESTO AND BROWN</u>	<u>125</u>		<u>TOTAL DEPTH</u>
<u>35</u>	<u>39</u>	<u>LIMESTONE GRAY</u>			
<u>39</u>	<u>56</u>	<u>SHALE GRAY</u>			
<u>56</u>	<u>61</u>	<u>LIMESTONE GRAY</u>			
<u>61</u>	<u>64</u>	<u>SHALE GRAY</u>			
<u>64</u>	<u>67</u>	<u>SHALE BROWN</u>			
<u>85</u>	<u>87</u>	<u>LIMESTONE</u>			
<u>87</u>	<u>91</u>	<u>SHALE GRAY</u>			
<u>91</u>	<u>94</u>	<u>LIMESTONE LIGHT GRAY</u>			
<u>94</u>	<u>103</u>	<u>SHALE GRAY</u>			
<u>103</u>	<u>109</u>	<u>LIMESTONE, WHITE</u>			

7 CONTRACTOR'S OR LANDOWNER'S CERTIFICATION: This water well was (1) constructed, (2) reconstructed, or (3) plugged under my jurisdiction and was completed on (mo/day/year) 4/13/01 and this record is true to the best of my knowledge and belief. KansasWater Well Contractor's Licence No. 585 This Water Well Record was completed on (mo/day/yr) 4/13/01under the business name of ASSOC. ENVIRONMENTAL POLL. by (signature) [Signature]