USE TYPEWRITER OR BALL POINT PEN-PRESS FIRMLY, PRINT CLEARLY.

WATER WELL RECORD
KSA 82a-1201-1215

Kansas Department of Health and Environment-Division of Environment
(Water well Contractors)
Topeka, Kansas 66620

1. Location of well:	County	Fraction	Section number	Township number	Range number
	Morris	NE 1/4 NW 1/4 NE 1/4	29	T 16 S	R 7 (E/W)

2. Distance and direction from nearest town or city: In Wilsey

Street address of well location if in city: NO Address – Small Town

3. Owner of well: Kirt Gentry
R.R. or street: Wilsey, Kan,
City, state, zip code:

4. Locate with "X" in section below:

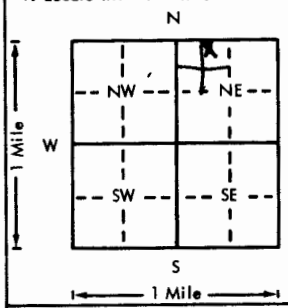

Sketch map:

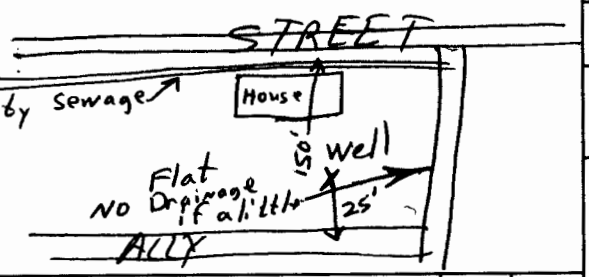

6. Bore hole dia. 6 1/2 in. Completion date 5-21-76
Well depth 112 ft.

7. X Cable tool __ Rotary __ Driven __ Dug
__ Hollow rod __ Jetted __ Bored __ Reverse rotary

8. Use: X Domestic __ Public supply __ Industry
__ Irrigation __ Air conditioning __ Stock
__ Lawn __ Oil field water __ Other

9. Casing: Material Pits Height: (Above) or below
Threaded ___ Welded glue Surface 18 in.
RMP X PVC ___ Weight ___ lbs./ft.
Dia. 5 in. to 22 ft. depth Wall Thickness: inches or
Dia. ___ in. to ___ ft. depth gage No. .200

10. Screen: Manufacturer's name Sunflower
Type RMP Dia. 5"
(Slot) gauze 1/8 Length 50'
Set between 72 ft. and 112 ft.
___ ft. and ___ ft.
Gravel pack? NO Size range of material

11. Static water level: ma./day/yr.
72 ft. below land surface Date 5-21-76

12. Pumping level below land surfaces:
___ ft. after ___ hrs. pumping ___ g.p.m.
___ ft. after ___ hrs. pumping ___ g.p.m.
Estimated maximum yield 3.5 g.p.m.

13. Water sample submitted: mo./day/yr.
__ Yes X No Date

14. Well head completion:
__ Pitless adapter 18 Inches above grade

15. Well grouted? Yes
With: __ Neat cement __ Bentonite X Concrete
Depth: From 3 ft. to 20 ft.

16. Nearest source of possible contamination:
ft. 150' Direction North Type Sewage
Well disinfected upon completion? X Yes __ No

17. Pump: X Not installed
Manufacturer's name
Model number HP Volts
Length of drop pipe ft. capacity g.p.m.
Type:
__ Submersible __ Turbine
__ Jet __ Reciprocating
__ Centrifugal __ Other

5. Type and color of material	From	To
Topsoil – Blk	0	2
Red Rock –	2	18
Lime – Broken – Yellow	18	34
Shale – Yel	34	36
Lime – Wht	36	46
Shale – Blu	46	59
Lime – Gray Abrasive	59	64
Shale – Gray	64	70
Lime – Gray – Break at 72' H^2O	70	88
Shale – Lite Gray	88	95
Red Rock –	95	101
Lime – Gray Abrasive	101	103
Shale – Gray	103	112

(Use a second sheet if needed)

18. Elevation:

Topography:
__ Hill
__ Slope
X Upland
__ Valley

19. Remarks: Concrete Slab to be installed by customer
X Kirt Gentry

20. Water well contractor's certification:
This well was drilled under my jurisdiction and this report is true to the best of my knowledge and belief.
Zinn Water Well Drilling 218
Business name License No.
Address Lost Springs, Kan
Signed Joseph A. Zinn Date 6-4-76
Authorized representative

T 16 R 7 (E/W) Sec 29 1/4 NE 1/4 NW 1/4 NE 1/4

Forward the white, blue and pink copies to the Department of Health and Environment

Form WWC-5

MI-1023