

CORRECTION TO WATER WELL RECORD (WWC-5)

The following correction(s) was made to the attached WWC-5 log, in order to file the item or to rectify lacking or incorrect information.

Fraction ( 1/4 1/4 1/4) Section-Township-Range changed:

listed as 29-16-7E

changed to NE SE SE, 29-16S-7E

Other changes: Initial statements: \_\_\_\_\_

Changed to: \_\_\_\_\_

Comments: well owner's current address is 1752 S. 1800 Rd.,  
Wilsey, KS.

verification method: Written & legal descriptions, well owner's address and  
area map on internet, and Wilsey 1:24,000 topo. map initials: DR date: 3/1/2002

submitted by: Kansas Geological Survey, Data Resources Library, 1930 Constant Ave., Lawrence, KS 66047-3726  
to: Kansas Dept of Health & Environment Bureau of Water Industrial Programs, Bldg 283, Forbes Field, KS 66620

USE TYPEWRITER OR BALL POINT PEN-PRESS FIRMLY, PRINT CLEARLY.


T R EW sec 1/4 1/4 1/4 No.

WATER WELL RECORD  
KSA 82a-1201-1215

Kansas State Dept. Of Health  
(Water Well Contractors)  
Forbes-Bldg. 740  
Topeka, Kansas 66620

1 Location of well: County MORRIS Township name ELM CREEK Fraction 9 NORTH Section number 29 Town number 16 Range number 7 EAST

Distance and direction from nearest town or city: 1/4 MILE SOUTH  
Street address of well location if in city:  
3 Owner of well: CHARLES AIKENS  
Address: R.R. 1 WILSEY KANSAS

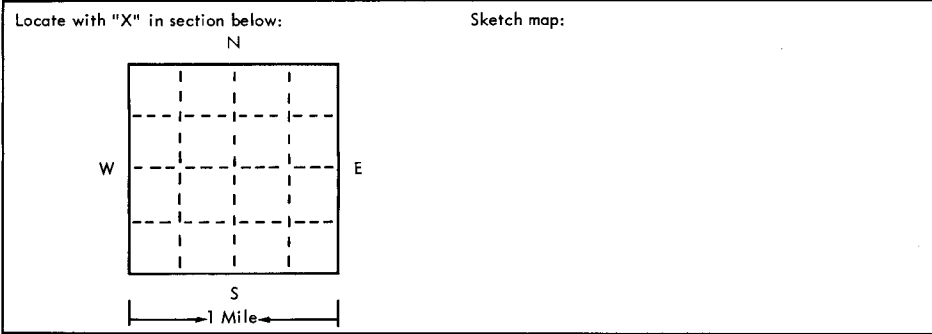

4 Well depth: 90 ft. Date of completion 8-2-75  
Well diameter 9 in.  
5  Cable tool  Rotary  Driven  Dug  
 Hollow rod  Jetted  Bored  Reverse rotary  
6 Use:  Domestic  Public supply  Industry  
 Irrigation  Air conditioning  Commercial  
 Test well  
7 Casing: Material STYRENE Height: above/below  
Threaded  Welded  Surface 12 in.  
Diam. \_\_\_\_\_ Weight \_\_\_\_\_ lbs./ft. \_\_\_\_\_  
5 in. to \_\_\_\_\_ ft. depth Drive shoe?  Yes  No  
5 in. to 90 ft. depth

2	Type and color of material	From	To
	CLAY RED	0	10
	LIME ROCK YELLOW	10	40
	SHALE BLUE	40	50
	LIME ROCK GRAY	50	65
	LIME ROCK WHITE	65	70
	LIME ROCK GRAY	70	75
	SHALE BLUE	75	88
	SHALE RED	88	90

(use a second sheet if needed)

8 Screen: Manufacturer JESS & LOWELL  
Type STYRENE Dia. 5  
Slot/gauze SAW BLADE length 20  
Set between 50 ft. and 21 ft.  
Fittings:  
Gravel pack  Yes  No Size range of material \_\_\_\_\_  
9 Static water level: 30 ft. below land surface Date Aug 10-75  
10 Pumping level below land surfaces:  
\_\_\_\_\_ ft. after \_\_\_\_\_ hrs. pumping \_\_\_\_\_ g.p.m.  
\_\_\_\_\_ ft. after \_\_\_\_\_ hrs. pumping \_\_\_\_\_ g.p.m.  
Estimated maximum yield \_\_\_\_\_ g.p.m.  
11 Water sample submitted:  
 Yes  No Date \_\_\_\_\_  
12 Well head completion:  
 Pitless adapter 19 inches above grade  
13 Well grouted?  Yes  No  
 Neat cement  Bentonite  CONCRETE  
Depth: From 1 ft. to 15 ft.  
14 Nearest source of possible contamination:  
ft. 100 Direction SOUTH Type \_\_\_\_\_  
Well disinfected upon completion?  Yes  No  
15 Pump:  Not installed  
Manufacturer's name \_\_\_\_\_  
Model number \_\_\_\_\_ HP \_\_\_\_\_ Volts \_\_\_\_\_  
Length of drop pipe \_\_\_\_\_ ft. capacity \_\_\_\_\_ g.p.m.  
Type:  
 Submersible  Turbine  
 Jet  Reciprocating  
 Centrifugal  Other

16 Remarks: elevation  
Topography:  
 Hill  
 Slope  
 Upland  
 Valley

17 Water well contractor's certification:  
This well was drilled under my jurisdiction and this report is true to the best of my knowledge and belief.  
Bob Adams 156  
Business name \_\_\_\_\_ License No. \_\_\_\_\_  
Address Council Bluffs  
Signed Bob Adams Date Aug 26 75  
Authorized representative