

CORRECTION TO WATER WELL RECORD (WWC-5)

The following correction(s) was made to the attached WWC-5 log, in order to file the item or to rectify lacking or incorrect information.

Fraction ( 1/4 1/4 1/4) Section-Township-Range changed:

listed as 29-16S-7E

changed to SW SE SE, 20-16S-7E

Other changes: Initial statements: \_\_\_\_\_

Changed to: \_\_\_\_\_

Comments: \_\_\_\_\_

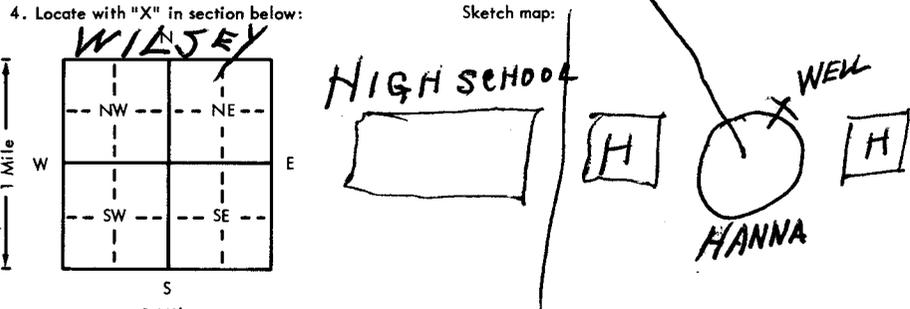
verification method: written & legal descriptions, platted map of Wilsey from County Assessor, and Wilsey 1:24,000 topo. map. initials: DR date: 1/28/2002

submitted by: Kansas Geological Survey, Data Resources Library, 1930 Constant Ave., Lawrence, KS 66047-3726  
to: Kansas Dept of Health & Environment Bureau of Water Industrial Programs, Bldg 283, Forbes Field, KS 66620

USE TYPEWRITER OR BALL POINT PEN-PRESS FIRMLY, PRINT CLEARLY.

WATER WELL RECORD  
KSA 82a-1201-1215

Kansas Department of Health and Environment-Division of Environment (Water well Contractors) Topeka, Kansas 66620

1. Location of well:	County <b>MORRIS</b>	Fraction 1/4 1/4 1/4	Section number <b>29</b>	Township number T <b>16</b> S	Range number R <b>7E</b> E/W
2. Distance and direction from nearest town or city: <b>AT WILSEY</b>			3. Owner of well: <b>LLOYD HANNA</b>		
Street address of well location if in city: <b>E 65th 10-12 BLDG 3 WATINS ED.</b>			R.R. or street: <b>RI</b>		
4. Locate with "X" in section below:			City, state, zip code: <b>COUNCIL GROVE KS 66846</b>		
Sketch map: 			6. Bore hole dia. <b>9</b> in. Completion date <b>10-3-77</b> Well depth <b>108</b> ft.		
5. Type and color of material			7. <input checked="" type="checkbox"/> Cable tool <input type="checkbox"/> Rotary <input type="checkbox"/> Driven <input type="checkbox"/> Dug <input type="checkbox"/> Hollow rod <input type="checkbox"/> Jetted <input type="checkbox"/> Bored <input type="checkbox"/> Reverse rotary		
			8. Use: <input checked="" type="checkbox"/> Domestic <input type="checkbox"/> Public supply <input type="checkbox"/> Industry <input type="checkbox"/> Irrigation <input type="checkbox"/> Air conditioning <input type="checkbox"/> Stock <input type="checkbox"/> Lawn <input type="checkbox"/> Oil field water <input type="checkbox"/> Other		
			9. Casing: Material <b>STYRAMA</b> Height: Above or below Threaded <input type="checkbox"/> Welded <input type="checkbox"/> Surface <input checked="" type="checkbox"/> in. RMP <input type="checkbox"/> PVC <input type="checkbox"/> Weight <b>2 1/2</b> lbs./ft. Dia. <b>5</b> in. to <b>60</b> ft. depth; Wall Thickness: inches or Dia. <input type="checkbox"/> in. to <input type="checkbox"/> ft. depth; gage No. <input type="checkbox"/>		
			10. Screen: Manufacturer's name <b>JESSY LOWEN</b> Type <b>200</b> Dia. <b>5</b> Slot/gauze <b>SAW BLADE</b> Length <input type="checkbox"/> Set between <b>60</b> ft. and <b>108</b> ft. <input type="checkbox"/> ft. and <input type="checkbox"/> ft. Gravel pack? <input type="checkbox"/> Size range of material <input type="checkbox"/>		
			11. Static water level: <input type="checkbox"/> mo./day/yr. <b>50</b> ft. below land surface Date <input type="checkbox"/>		
			12. Pumping level below land surfaces: <input type="checkbox"/> ft. after <input type="checkbox"/> hrs. pumping <input type="checkbox"/> g.p.m. <input type="checkbox"/> ft. after <input type="checkbox"/> hrs. pumping <input type="checkbox"/> g.p.m. Estimated maximum yield <input type="checkbox"/> g.p.m.		
			13. Water sample submitted: <input type="checkbox"/> mo./day/yr. <input type="checkbox"/> Yes <input checked="" type="checkbox"/> No Date <input type="checkbox"/>		
			14. Well head completion: <input checked="" type="checkbox"/> Pitless adapter <b>2 ft</b> inches above grade		
			15. Well grouted? <input checked="" type="checkbox"/> With: <input checked="" type="checkbox"/> Neat cement <input type="checkbox"/> Bentonite <input type="checkbox"/> Concrete Depth: From <b>0</b> ft. to <b>15</b> ft.		
			16. Nearest source of possible contamination: ft. <b>75</b> Direction <b>WEST &amp; EAST to houses</b> Well disinfected upon completion? <input checked="" type="checkbox"/> Yes <input type="checkbox"/> No		
			17. Pump: <input type="checkbox"/> Not installed Manufacturer's name <b>PUMPER</b> Model number <input type="checkbox"/> HP <b>1/2</b> Volts <b>220</b> Length of drop pipe <input type="checkbox"/> ft. capacity <input type="checkbox"/> g.p.m. Type: <input checked="" type="checkbox"/> Submersible <input type="checkbox"/> Turbine <input type="checkbox"/> Jet <input type="checkbox"/> Reciprocating <input type="checkbox"/> Centrifugal <input type="checkbox"/> Other		
(Use a second sheet if needed)					
18. Elevation:		19. Remarks:		20. Water well contractor's certification: This well was drilled under my jurisdiction and this report is true to the best of my knowledge and belief. <b>L H HRAUSE SHOP 156</b> Business name License No. Address <b>COUNCIL GROVE KS</b> Signed <b>[Signature]</b> Date <b>10-20-77</b> Authorized representative	
Topography: <input type="checkbox"/> Hill <input type="checkbox"/> Slope <input type="checkbox"/> Upland <input type="checkbox"/> Valley				16 7E 29 1/4 1/4 1/4	