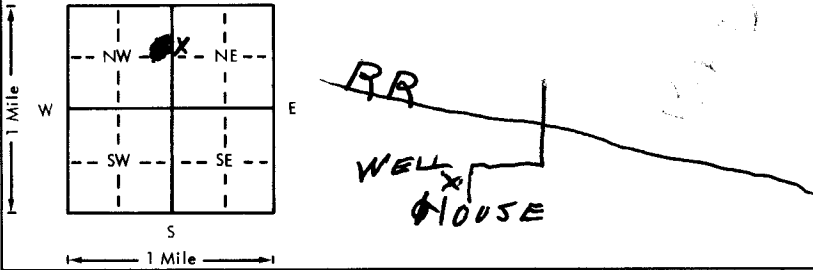


USE TYPEWRITER OR BALL
POINT PEN-PRESS FIRMLY,
PRINT CLEARLY.

WATER WELL RECORD
KSA 82a-1201-1215

Kansas Department of Health and
Environment-Division of Environment
(Water well Contractors)
Topeka, Kansas 66620

1. Location of well:		County MORRIS	Fraction SW 1/4 NW 1/4 NE 1/4	Section number 29	Township number T 16 S R 7 E	Range number 7
2. Distance and direction from nearest town or city: Street address of well location if in city: BLOCK 9 LOTS 123456789 181112 WILSEY RD			3. Owner of well: NORMAN STANDER R.R. or street: City, state, zip code: WILSEY KS 66873			
4. Locate with "X" in section below:		Sketch map:		6. Bore hole dia. 4 in. Completion date 10-30-77 Well depth 65 ft.		
				7. <input checked="" type="checkbox"/> Cable tool <input type="checkbox"/> Rotary <input type="checkbox"/> Driven <input type="checkbox"/> Dug <input type="checkbox"/> Hollow rod <input type="checkbox"/> Jetted <input type="checkbox"/> Bored <input type="checkbox"/> Reverse rotary		
5. Type and color of material		From		To		8. Use: <input checked="" type="checkbox"/> Domestic <input type="checkbox"/> Public supply <input type="checkbox"/> Industry <input type="checkbox"/> Irrigation <input type="checkbox"/> Air conditioning <input type="checkbox"/> Stock <input type="checkbox"/> Lawn <input type="checkbox"/> Oil field water <input type="checkbox"/> Other
RED CLAY		0		8		9. Casing: Material STEEL Height: 24 or below Threaded <input type="checkbox"/> Welded <input type="checkbox"/> Surface 24 in. RMP <input type="checkbox"/> PVC <input type="checkbox"/> Weight 11.5 lbs./ft. Dia. 5 in. to 4.5 ft. depth Wall Thickness: 1/8 in. Dia. <input type="checkbox"/> in. to <input type="checkbox"/> ft. depth gage No. 250
YELLOW ROCK		8		26		10. Screen: Manufacturer's name JRSS & HOWELL Type 200 Dia. 5 Slot/gauze SAV BLADE Length 10 Set between 45 ft. and 65 ft. ft. and <input type="checkbox"/> ft. Gravel pack? <input type="checkbox"/> Size range of material <input type="checkbox"/>
SHALE BLUE		26		30		11. Static water level: 35 ft. below land surface Date 10-15-77 mo./day/yr.
LIME ROCK YELLOW		30		40		12. Pumping level below land surfaces: <input type="checkbox"/> ft. after <input type="checkbox"/> hrs. pumping <input type="checkbox"/> g.p.m. <input type="checkbox"/> ft. after <input type="checkbox"/> hrs. pumping <input type="checkbox"/> g.p.m. Estimated maximum yield <input type="checkbox"/> g.p.m.
SHALE BLUE		40		50		13. Water sample submitted: <input type="checkbox"/> Yes <input checked="" type="checkbox"/> No Date <input type="checkbox"/>
LIME ROCK GRAY		50		65		14. Well head completion: <input checked="" type="checkbox"/> Pitless adapter 24 inches above grade
						15. Well grouted? <input checked="" type="checkbox"/> With: <input checked="" type="checkbox"/> neat cement <input type="checkbox"/> Bentonite <input type="checkbox"/> Concrete Depth: From 0 ft. to 15 ft.
						16. Nearest source of possible contamination: ft. 150 Direction NORTH Type HOME Well disinfected upon completion? <input checked="" type="checkbox"/> Yes <input type="checkbox"/> No
						17. Pump: Manufacturer's name Pump Co Model number 280100401 HP 1/2 Volts 220 Length of drop pipe 60 ft. capacity 10 g.p.m. Type: <input checked="" type="checkbox"/> Submersible <input type="checkbox"/> Turbine <input type="checkbox"/> Jet <input type="checkbox"/> Reciprocating <input type="checkbox"/> Centrifugal <input type="checkbox"/> Other
						20. Water well contractor's certification: This well was drilled under my jurisdiction and this report is true to the best of my knowledge and belief. L H KRAUSE SHOP 156 Business name License No. Address COUNCIL GROVE Signed L H Krause Date 10-27 Authorized representative
18. Elevation:		19. Remarks:				
Topography: <input type="checkbox"/> Hill <input type="checkbox"/> Slope <input type="checkbox"/> Upland <input type="checkbox"/> Valley						

Forward the white, blue and pink copies to the Department of Health and Environment

Form WWC-5