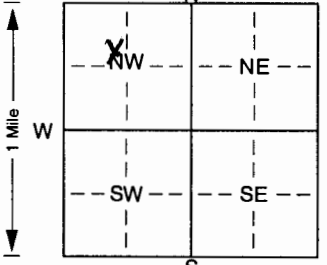


1] LOCATION OF WATER WELL: Fraction SE 1/4 NW 1/4 NW 1/4 Section Number 2 Township, Number T 16 S Range Number R 8 E
 County: Morris

Distance and direction from nearest town or city street address of well if located within city? FROM Council Grove go 2 miles north 177 1/2 east

2] WATER WELL OWNER: John Baker
 RR#, St. Address, Box #: 22 North 4th Board of Agriculture, Division of Water Resources
 City, State, ZIP Code: Council Grove, Ks. 66846 Application Number:

3] LOCATE WELL'S LOCATION WITH AN "X" IN SECTION BOX:

 4] DEPTH OF COMPLETED WELL: 20 ft. ELEVATION:
 Depth(s) Groundwater Encountered 1. 8.2 ft. 2. ft. 3. ft.
 WELL'S STATIC WATER LEVEL: 80 ft. below land surface measured on mo/day/yr
 Pump test data: Well water was ft. after hours pumping gpm
 Est. Yield 3 gpm; Well water was ft. after hours pumping gpm
 Bore Hole Diameter: 9 in. to 120 ft., and in. to ft.
 WELL WATER TO BE USED AS: 5 Public water supply 8 Air conditioning 11 Injection well
Domestic 3 Feedlot 6 Oil field water supply 9 Dewatering 12 Other (Specify below)
 2 Irrigation 4 Industrial 7 Domestic (lawn & garden) 10 Monitoring well
 Was a chemical/bacteriological sample submitted to Department? Yes. No. ; If yes, mo/day/yr sample was submitted
 Water Well Disinfected? Yes No

5] TYPE OF BLANK CASING USED:
 1 Steel 2 PVC 3 RMP (SR) 4 ABS 5 Wrought iron 6 Asbestos-Cement 7 Fiberglass 8 Concrete tile 9 Other (specify below) CASING JOINTS: Clipped Clamped
 Welded Threaded
 Blank casing diameter 5 in. to 100 ft., Dia. in. to ft., Dia. in. to ft.
 Casing height above land surface: 3 in., weight Sch 40 lbs./ft. Wall thickness or gauge No.
 TYPE OF SCREEN OR PERFORATION MATERIAL: PVC 10 Asbestos-cement 11 Other (specify)
 1 Steel 3 Stainless steel 5 Fiberglass 8 RMP (SR) 9 ABS 12 None used (open hole)
 2 Brass 4 Galvanized steel 6 Concrete tile 9 ABS 12 None used (open hole)
 SCREEN OR PERFORATION OPENINGS ARE:
 1 Continuous slot Mill slot 25/11000 5 Gauzed wrapped 8 Saw cut 11 None (open hole)
 2 Louvered shutter 4 Key punched 6 Wire wrapped 9 Drilled holes
 7 Torch cut 10 Other (specify) ft.
 SCREEN-PERFORATED INTERVALS: From 100 ft. to 120 ft., From ft. to ft.
 From ft. to ft., From ft. to ft.
 GRAVEL PACK INTERVALS: From 25 ft. to 120 ft., From ft. to ft.
 From ft. to ft., From ft. to ft.

6] GROUT MATERIAL: 1 Neat cement 2 Cement grout Bentonite 4 Other
 Grout Intervals: From 0 ft. to 25 ft., From ft. to ft., From ft. to ft.
 What is the nearest source of possible contamination:
 1 Septic tank 4 Lateral lines None close 7 Pit privy 10 Livestock pens 14 Abandoned water well
 2 Sewer lines 5 Cess pool 8 Sewage lagoon 11 Fuel storage 15 Oil well/Gas well
 3 Watertight sewer lines 6 Seepage pit 9 Feedyard 12 Fertilizer storage 16 Other (specify below)
 13 Insecticide storage
 Direction from well? How many feet?

| FROM | TO | LITHOLOGIC LOG | FROM | TO | PLUGGING INTERVALS |
|------|-----|--------------------|------|----|--------------------|
| 0 | 1 | Top Soil | | | |
| 1 | 9 | Brown clay | | | |
| 9 | 11 | Limestone | | | |
| 11 | 14 | Flint Rock | | | |
| 14 | 19 | Gray Shale | | | |
| 19 | 44 | Tan Shale | | | |
| 44 | 55 | Limestone | | | |
| 55 | 66 | Brown Shale | | | |
| 66 | 71 | Limestone | | | |
| 71 | 82 | Gray Shale | | | |
| 82 | 89 | Limestone | | | |
| 89 | 93 | Gray Shale (Light) | | | |
| 93 | 110 | Limestone | | | |
| 110 | 120 | Gray Shale | | | |

7] CONTRACTOR'S OR LANDOWNER'S CERTIFICATION: This water well was (1) constructed, (2) reconstructed, or (3) plugged under my jurisdiction and was completed on (mo/day/year) 7/15/81 and this record is true to the best of my knowledge and belief. Kansas Water Well Contractor's Licence No. 4518/2001 This Water Well Record was completed on (mo/day/yr) 5/6/2001 under the business name of Haldeman Well Drilling by (signature) Craig M. CWP/PE