

1 LOCATION OF WATER WELL:	Fraction	Section Number	Township Number	Range Number
County: <u>Morris</u>	<u>SE 1/4 SW 1/4 NW 1/4</u>	<u>21</u>	T <u>16</u> S	R <u>8</u> <u>EW</u>

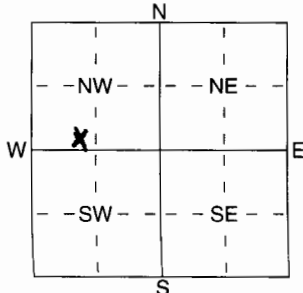
Distance and direction from nearest town or city street address of well if located within city?

2 3/4 West & 1 South of Council Grove

2 WATER WELL OWNER:

RR#, St. Address, Box # :
City, State, ZIP Code :Kevin Burnett
1086 V Ave
Council Grove, KS 66846Board of Agriculture, Division of Water Resources
Application Number:

3 LOCATE WELL'S LOCATION WITH AN "X" IN SECTION BOX:

4 DEPTH OF COMPLETED WELL 61 ft. ELEVATION:

Depth(s) Groundwater Encountered 1 33 ft. 2 ft. 3 ft.

WELL'S STATIC WATER LEVEL 2.7 ft. below land surface measured on mo/day/yr MAY 17 05

Pump test data: Well water was ft. after hours pumping gpm

Est. Yield 2.0 gpm: Well water was ft. after hours pumping gpm

WELL WATER TO BE USED AS: 5 Public water supply 8 Air conditioning 11 Injection well

① Domestic 3 Feedlot 6 Oil field water supply 9 Dewatering 12 Other (Specify below)

2 Irrigation 4 Industrial 7 Domestic (lawn & garden) 10 Monitoring well

Was a chemical/bacteriological sample submitted to Department? Yes No X; If yes, mo/day/yr sample was submitted Water Well Disinfected? Yes No

5 TYPE OF BLANK CASING USED:

5 Wrought iron

8 Concrete tile

CASING JOINTS: Glued X Clamped

6 Asbestos-Cement

9 Other (specify below)

Welded

7 Fiberglass

Threaded

1 Steel

3 RMP (SR)

2 PVC

4 ABS

Blank casing diameter 5 in. to 30 ft., Dia in. to ft., Dia in. to ft.Casing height above land surface 18 in., weight lbs./ft. Wall thickness or gauge No. SDR-26

TYPE OF SCREEN OR PERFORATION MATERIAL:

1 Steel

3 Stainless Steel

5 Fiberglass

8 RMP (SR)

10 Asbestos-Cement

2 Brass

4 Galvanized Steel

6 Concrete tile

9 ABS

11 Other (Specify)

12 None used (open hole)

SCREEN OR PERFORATION OPENINGS ARE:

1 Continuous slot

3 Mill slot

5 Gauzed wrapped

8 Saw cut

11 None (open hole)

2 Louvered shutter

4 Key punched

6 Wire wrapped

9 Drilled holes

7 Torch cut

10 Other (specify) ft.

SCREEN-PERFORATED INTERVALS: From 30 ft. to 61 ft., From ft. to ft.GRAVEL PACK INTERVALS: From NONE ft. to ft., From ft. to ft.

6 GROUT MATERIAL:

① Neat cement

2 Cement grout

3 Bentonite

4 Other

Grout Intervals: From 3 ft. to 26 ft., From ft. to ft., From ft. to ft.

What is the nearest source of possible contamination:

1 Septic tank

4 Lateral lines

7 Pit privy

10 Livestock pens

14 Abandoned water well

2 Sewer lines

5 Cess pool

⑧ Sewage lagoon

11 Fuel storage

15 Oil well/Gas well

3 Watertight sewer lines

6 Seepage pit

9 Feedyard

12 Fertilizer storage

16 Other (specify below)

13 Insecticide storage

Direction from well? WestHow many feet? 300

FROM	TO	LITHOLOGIC LOG	FROM	TO	PLUGGING INTERVALS
<u>0</u>	<u>3</u>	<u>Top</u>	<u>45</u>	<u>47</u>	<u>Shale Gray</u>
<u>3</u>	<u>10</u>	<u>Shale Brn</u>	<u>47</u>	<u>61</u>	<u>LIME with DK Blue-black</u>
<u>10</u>	<u>14</u>	<u>Shale Gray Blue</u>			<u>Flint. Turned soft at</u>
<u>14</u>	<u>19</u>	<u>Shale Red</u>			<u>55' then back Hd in 2'</u>
<u>19</u>	<u>25</u>	<u>Shale Green</u>			
<u>25</u>	<u>33</u>	<u>LIME lite / Flint</u>			
<u>33</u>	<u>34</u>	<u>Frac full of Shale Peach</u>			
<u>34</u>	<u>36</u>	<u>LIME lite / Flint</u>			
<u>36</u>	<u>39</u>	<u>Shale Gray</u>			
<u>39</u>	<u>40</u>	<u>LIME TAN</u>			
<u>40</u>	<u>42</u>	<u>Shale Brn</u>			
<u>42</u>	<u>43</u>	<u>LIME Gray</u>			
<u>43</u>	<u>44</u>	<u>Shale Blueish Gray</u>			
<u>44</u>	<u>45</u>	<u>LIME</u>			

7 CONTRACTOR'S OR LANDOWNER'S CERTIFICATION: This water well was ① constructed, (2) reconstructed, or (3) plugged under my jurisdiction and was completed on (mo/day/year) May 17 05 and this record is true to the best of my knowledge and belief. KansasWater Well Contractor's Licence No 218 This Water Well Record was completed on (mo/day/yr) Jun 10 05
under the business name of Zinn Water Well Drllg. by (signature) Joseph A Zinn