WATER WELL RECORD Form WWC-5 KSA 82a-1212 ID No. _____

1 LOCATION OF WATER WELL: County: MORRIS | Fraction: NW ¼ SE ¼ NE ¼ | Section Number: 7 | Township Number: T 16 S | Range Number: R 8 (E) W

Distance and direction from nearest town or city street address of well if located within city?
FROM COUNCIL GROVE: 1 MILE WEST, 1 MILE NORTH, 2½ WEST AND ¼ MILE SOUTH

2 WATER WELL OWNER: ADAMS LUMBER, ATTN STEVE ADAMS
RR#, St. Address, Box # : 203 E. MAIN
City, State, ZIP Code : COUNCIL GROVE, KS. 66846
Board of Agriculture, Division of Water Resources Application Number: —

3 LOCATE WELL'S LOCATION WITH AN "X" IN SECTION BOX:

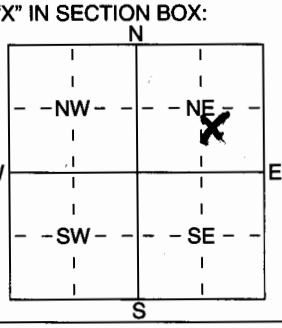

4 DEPTH OF COMPLETED WELL 142 ft. ELEVATION: —
Depth(s) Groundwater Encountered 1 125 ft. 2 — ft. 3 — ft.
WELL'S STATIC WATER LEVEL 78 ft. below land surface measured on mo/day/yr 4/5/06
Pump test data: Well water was — ft. after — hours pumping — gpm
Est. Yield 2.0 gpm: Well water was — ft. after — hours pumping — gpm
WELL WATER TO BE USED AS: 1 (Domestic) 2 Irrigation 3 Feedlot 4 Industrial 5 Public water supply 6 Oil field water supply 7 Domestic (lawn & garden) 8 Air conditioning 9 Dewatering 10 Monitoring well 11 Injection well 12 Other (Specify below)

Was a chemical/bacteriological sample submitted to Department? Yes ____ No X; If yes, mo/day/yrs sample was submitted
Water Well Disinfected? Yes X No

5 TYPE OF BLANK CASING USED: 1 Steel (2 PVC) 3 RMP (SR) 4 ABS 5 Wrought iron 6 Asbestos-Cement 7 Fiberglass 8 Concrete tile 9 Other (specify below)
CASING JOINTS: Glued X Clamped — Welded — Threaded —
Blank casing diameter 5 in. to 122 ft., Dia — in. to — ft., Dia — in. to — ft.
Casing height above land surface 24 in., weight — lbs./ft. Wall thickness or guage No. SDR21

TYPE OF SCREEN OR PERFORMATION MATERIAL: (7 PVC) 1 Steel 2 Brass 3 Stainless Steel 4 Galvanized Steel 5 Fiberglass 6 Concrete tile 8 RMP (SR) 9 ABS 10 Asbestos-Cement 11 Other (Specify) 12 None used (open hole)

SCREEN OR PERFORATION OPENINGS ARE: 1 Continuous slot (3 Mill slot) .025 2 Louvered shutter 4 Key punched 5 Guazed wrapped 6 Wire wrapped 7 Torch cut 8 Saw cut 9 Drilled holes 10 Other (specify) 11 None (open hole)

SCREEN-PERFORATED INTERVALS: From 122 ft. to 142 ft., From — ft. to — ft.
From — ft. to — ft., From — ft. to — ft.
GRAVEL PACK INTERVALS: From 25 ft. to 142 ft., From — ft. to — ft.
From — ft. to — ft., From — ft. to — ft.

6 GROUT MATERIAL: 1 Neat cement 2 Cement grout (3 Bentonite) 4 Other —
Grout Intervals: From 3 ft. to 25 ft., From — ft. to — ft., From — ft. to — ft.

What is the nearest source of possible contamination:
1 Septic tank 2 Sewer lines 3 Watertight sewer lines 4 Lateral lines 5 Cess pool 6 Seepage pit 7 Pit privy 8 Sewage lagoon 9 Feedyard 10 Livestock pens 11 Fuel storage 12 Fertilizer storage 13 Insecticide storage 14 Abandoned water well 15 Oil well/Gas well (16 Other) (specify below) HOUSE
Direction from well? EAST How many feet? 50

FROM	TO	LITHOLOGIC LOG	FROM	TO	PLUGGING INTERVALS
0	1	SOIL			
1	20	LIMESTONE			
20	22	SHALE, BROWN			
22	27	LIMESTONE W/ CHERT			
27	87	SHALE, GRAY TO REDDISH GRAY			
87	90	LIMESTONE			
90	123	SHALE, GRAY			
123	130	LIMESTONE			
130	142	SHALE, GRAY			

7 CONTRACTOR'S OR LANDOWNER'S CERTIFICATION: This water well was (1) constructed, (2) reconstructed, or (3) plugged under my jurisdiction and was completed on (mo/day/year) 4/20/06 and this record is true to the best of my knowledge and belief. Kansas Water Well Contractor's Licence No 760 This Water Well Record was completed on (mo/day/yr) — under the business name of ASSOCIATED DRILLING INC. by (signature) [signature]

INSTRUCTIONS: Use typewriter or ball point pen. *PLEASE PRESS FIRMLY* and *PRINT* clearly. Please fill in blanks, underline or circle the correct answers. Send top three copies to Kansas Department of Health and Environment, Bureau of Water, Geology Section, 1000 SW Jackson St., Suite 420, Topeka, Kansas 66612-1367. Telephone 785-296-5522. Send one to WATER WELL OWNER and retain one for your records. Fee of $5.00 for each constructed well.