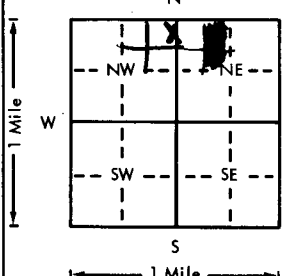
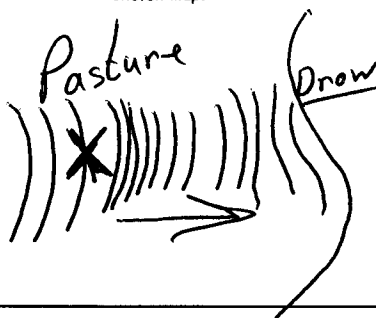


USE TYPEWRITER OR BALL  
POINT PEN-PRESS FIRMLY,  
PRINT CLEARLY.

WATER WELL RECORD  
KSA 82a-1201-1215

Kansas Department of Health and  
Environment-Division of Environment  
(Water well Contractors)  
Topeka, Kansas 66620

1. Location of well:		County <b>Morris</b>	Fraction <b>NE 1/4 NE 1/4 NW 1/4</b>	Section number <b>2</b>	Township number <b>T 16 S R 8 E</b>	Range number <b>8 E</b>
2. Distance and direction from nearest town or city: <b>2 mile North of Council Grove</b> Street address of well location if in city:				3. Owner of well: <b>Leland Scott</b> R.R. or street: <b>RR1</b> City, state, zip code: <b>Council Grove, Kan</b>		
4. Locate with "X" in section below:		Sketch map:		6. Bore hole dia. <b>6 1/2</b> in. Completion date <b>10-16-77</b> Well depth <b>92</b> ft.		
				7. <input checked="" type="checkbox"/> Cable tool <input checked="" type="checkbox"/> Rotary <input type="checkbox"/> Driven <input type="checkbox"/> Dug <input type="checkbox"/> Hollow rod <input type="checkbox"/> Jetted <input type="checkbox"/> Bored <input type="checkbox"/> Reverse rotary		
5. Type and color of material		From To		8. Use: <input type="checkbox"/> Domestic <input type="checkbox"/> Public supply <input type="checkbox"/> Industry <input type="checkbox"/> Irrigation <input type="checkbox"/> Air conditioning <input checked="" type="checkbox"/> Stock <input type="checkbox"/> Lawn <input type="checkbox"/> Oil field water <input type="checkbox"/> Other		
Topsoil - Blk		0 2		9. Casing: Material <b>PIEs</b> Height: <b>Above</b> or below Threaded <input type="checkbox"/> Welded <input checked="" type="checkbox"/> Surface <b>16</b> in. RMP <input checked="" type="checkbox"/> PVC <input type="checkbox"/> Weight <input type="checkbox"/> lbs./ft. Dia. <b>5</b> in. to <b>35</b> ft. depth Wall Thickness: inches or Dia. <input type="checkbox"/> in. to <input type="checkbox"/> ft. depth gage No. <b>1200</b>		
LIME - Broken - White		2 6		10. Screen: Manufacturer's name <b>Sunflower</b>		
LIME - White		6 10		Type <b>RMP</b> Dia. <b>5"</b>		
Shale - Yel		10 12		Slot gauge <b>10</b> Length <b>57</b>		
LIME - White		12 15		Set between <b>35</b> ft. and <b>92</b> ft.		
Shale - Shale Gray		15 16		<input type="checkbox"/> ft. and <input type="checkbox"/> ft.		
LIME - Yel		16 21		Gravel pack? <b>NO</b> Size range of material <input type="checkbox"/>		
Shale - Yel		21 28		11. Static water level: <input type="checkbox"/> mo./day/yr. <b>35</b> ft. below land surface Date <b>10-16-77</b>		
LIME Separated by layers of Shale - Yel		28 34		12. Pumping level below land surfaces:		
Shale - Brownish Yellow		34 35		<input type="checkbox"/> ft. after <input type="checkbox"/> hrs. pumping <input type="checkbox"/> g.p.m.		
LIME - TAN		35 38		<input type="checkbox"/> ft. after <input type="checkbox"/> hrs. pumping <input type="checkbox"/> g.p.m.		
Shale & Broken LIME Yel		38 42		Estimated maximum yield <input type="checkbox"/> g.p.m.		
LIME & Blue Flint		42 46		13. Water sample submitted: <input type="checkbox"/> mo./day/yr.		
Shale - Brw		46 49		Yes <input checked="" type="checkbox"/> No <input type="checkbox"/> Date <input type="checkbox"/>		
LIME - Gray		49 53		14. Well head completion:		
Red Rock - Red		53 60		<input type="checkbox"/> Pitless adapter <b>16</b> inches above grade		
LIME - Gray with Blue Flint		60 67		15. Well grouted? <b>Yes</b>		
Shale - Blue		67 70		With: <input type="checkbox"/> Neat cement <input type="checkbox"/> Bentonite <input checked="" type="checkbox"/> Concrete		
LIME - Gray		70 73		Depth: From <b>0</b> ft. to <b>16</b> ft.		
Shale - Dark		73 75		16. Nearest source of possible contamination:		
LIME / Blue Flint		75 79		ft. <b>300</b> Direction <b>E</b> Type <b>RAVINE</b>		
Shale - Blue		79 83		Well disinfected upon completion? <input checked="" type="checkbox"/> Yes <input type="checkbox"/> No		
LIME - Gray		83 85		17. Pump:		
Shale - Blue		85 87		<input type="checkbox"/> Not installed		
LIME - Gray		87 92		Manufacturer's name <input type="checkbox"/>		
				Model number <input type="checkbox"/> HP <input type="checkbox"/> Volts <input type="checkbox"/>		
				Length of drop pipe <input type="checkbox"/> ft. capacity <input type="checkbox"/> g.p.m.		
				Type: <b>Windmill</b> <b>2 1/2"</b> <b>Cylinder</b>		
				<input type="checkbox"/> Submersible <input type="checkbox"/> Turbine		
				<input type="checkbox"/> Jet <input type="checkbox"/> Reciprocating		
				<input type="checkbox"/> Centrifugal <input checked="" type="checkbox"/> Other		
18. Elevation:		19. Remarks:		20. Water well contractor's certification:		
Topography:				This well was drilled under my jurisdiction and this report		
<input checked="" type="checkbox"/> Hill				is true to the best of my knowledge and belief.		
<input checked="" type="checkbox"/> Slope				<b>Zinn Water Well Drilling 218</b>		
<input type="checkbox"/> Upland				Business name <b>Lost Springs, Kan</b> License No. <input type="checkbox"/>		
<input type="checkbox"/> Valley				Address <b>Joseph A. Zinn</b> Date <b>10-16-77</b>		
				Signed <b>Joseph A. Zinn</b> authorized representative		

Forward the white, blue and pink copies to the Department of Health and Environment

Form WWC-5