

CORRECTION TO WATER WELL RECORD (WWC-5)

The following correction(s) was made to the attached WWC-5 log, in order to file the item or to rectify lacking or incorrect information.

Fraction (1/4 1/4 1/4) Section-Township-Range changed:

listed as NW 1/4 N 1/4, 7-16-S-R-8

changed to NE NW NE, 7-16-S-8E

Other changes: Initial statements: _____

Changed to: _____

Comments: _____

verification method: Written & legal descriptions, platted map of Council Grove Lake
from County Assessor, and Council Grove Lake 1:24,000 initials: DRd date: 1/28/2002
topo. map.

submitted by: Kansas Geological Survey, Data Resources Library, 1930 Constant Ave., Lawrence, KS 66047-3726
to: Kansas Dept of Health & Environment Bureau of Water Industrial Programs, Bldg 283, Forbes Field, KS 66620

USE TYPEWRITER OR BALL POINT PEN-PRESS FIRMLY, PRINT CLEARLY.

T R EW sec 1/4 1/4 1/4 No.

WATER WELL RECORD
KSA 82a-1201-1215

Kansas State Dept. Of Health
(Water Well Contractors)
Forbes-Bldg. 740
Topeka, Kansas 66620


on your books

1 Location of well:	County MORRIS	Township name TWO	Fraction NW 1/4 N 1/4	Section number 7	Town number 16-8	Range number R-8-
---------------------	-------------------------	-----------------------------	---------------------------------	----------------------------	----------------------------	-----------------------------

Distance and direction from nearest town or city: _____

Street address of well location if in city: **B50**

3 Owner of well: **HARRY R BLY**
Address: **1729 VAUGUN DR
MANHATTAN KS 66502**

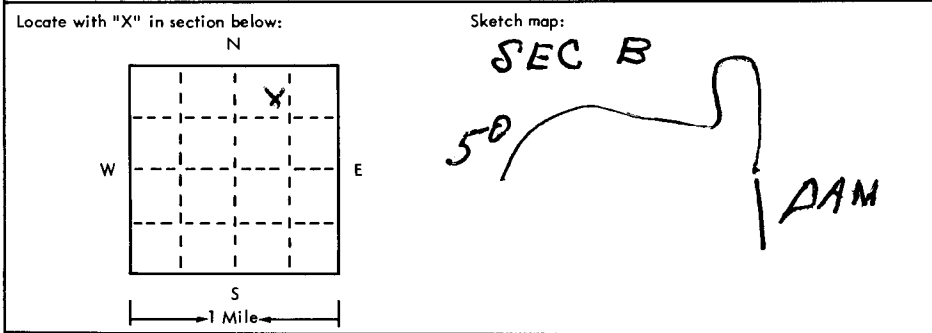

4 Well depth: **60** ft. Date of completion **7-10-75**
Well diameter **9** in.

5 Cable tool Rotary Driven Dug
 Hollow rod Jetted Bored Reverse rotary

6 Use: Domestic Public supply Industry
 Irrigation Air conditioning Commercial
 Test well **NO MAN**

7 Casing: Material **STYRENE** (above/below)
Threaded Welded Surface **(12)** in.
Diam. _____ Weight _____ lbs./ft. _____
_____ in. to _____ ft. depth! Drive shoe? Yes No
_____ in. to _____ ft. depth!

2	Type and color of material	From	To
	DIRT & GRAVEL	0	4
	LIME ROCK YELLOW	4	23
	SHALE BLUE	23	30
	SHALE RED	30	35
	SHALE RED	35	40
	LIMEROCK GRAY	40	45
	SHALE BLUE	45	60
(use a second sheet if needed)			

8 Screen: Manufacturer **JESSY LOWELL**
Type **STYRENE** Dia. **5**
Slot/gauze **SAND BLANK** length **20**
Set between **40** ft. and **60** ft.
Fittings: Gravel pack Yes No Size range of material _____

9 Static water level: **20** ft. below land surface Date **7-10-75**

10 Pumping level below land surfaces:
_____ ft. after _____ hrs. pumping _____ g.p.m.
_____ ft. after _____ hrs. pumping _____ g.p.m.
Estimated maximum yield _____ g.p.m.

11 Water sample submitted:
 Yes No Date _____

12 Well head completion:
 Pitless adapter **12** inches above grade

13 Well grouted? Yes No
 Neat cement Bentonite Concrete
Depth: From **0** ft. to **15** ft.

14 Nearest source of possible contamination: **Cabins**
ft. _____ Direction **East & West** Type _____
Well disinfected upon completion? Yes No

15 Pump: Not installed
Manufacturer's name **POMPCO**
Model number _____ HP **1/2** Volts **220**
Length of drop pipe **53** ft. capacity _____ g.m.p.
Type:
 Submersible Turbine
 Jet Reciprocating
 Centrifugal Other

16 Remarks: elevation **Was holding up on digging line**

Topography:
 Hill
 Slope **to SOUTH**
 Upland
 Valley

17 Water well contractor's certification:
This well was drilled under my jurisdiction and this report is true to the best of my knowledge and belief.
HARRY R BLY **1729 VAUGUN DR**
Business name _____ License No. _____
Address **1729 VAUGUN DR**
Signed **HARRY R BLY** Date **7-29-75**
Authorized representative