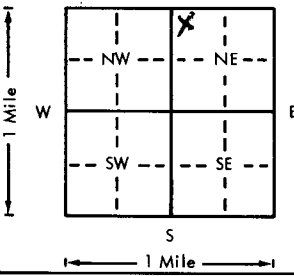
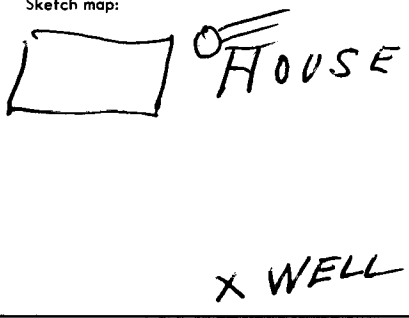


USE TYPEWRITER OR BALL
POINT PEN-PRESS FIRMLY,
PRINT CLEARLY.

WATER WELL RECORD
KSA 82a-1201-1215

Kansas Department of Health and
Environment-Division of Environment
(Water well Contractors)
Topeka, Kansas 66620

1. Location of well:		County MORRIS	Fraction 1/4 1/4 1/4 1/4	Section number 7	Township number T 16 S	Range number R 8 E
2. Distance and direction from nearest town or city:		3. Owner of well: BILL MCCREARY B41A LAKE				
Street address of well location if in city: 4 W of Council Grove		R.R. or street: 214 N JEFFERSON City, state, zip code: WELLINGTON KS 67152				
4. Locate with "X" in section below:		Sketch map:		6. Bore hole dia. 8 in. Completion date 9-22-80 Well depth 137 ft.		
				7. <input checked="" type="checkbox"/> Cable tool <input type="checkbox"/> Rotary <input type="checkbox"/> Driven <input type="checkbox"/> Dug <input type="checkbox"/> Hollow rod <input type="checkbox"/> Jetted <input type="checkbox"/> Bored <input type="checkbox"/> Reverse rotary		
5. Type and color of material		From	To	8. Use: <input checked="" type="checkbox"/> Domestic <input type="checkbox"/> Public supply <input type="checkbox"/> Industry <input type="checkbox"/> Irrigation <input type="checkbox"/> Air conditioning <input type="checkbox"/> Stock <input type="checkbox"/> Lawn <input type="checkbox"/> Oil field water <input type="checkbox"/> Other		
DIRTY & GRAVE		0	3	9. Casing: Material STEEL Height: 18 in. Threaded <input type="checkbox"/> Welded <input type="checkbox"/> Surface <input type="checkbox"/> RMP <input type="checkbox"/> PVC <input type="checkbox"/> Weight 18 lbs./ft. Dia. 5 in. to 117 ft. depth Wall Thickness: inches or Dia. in. to ft. depth gage No. 0208		
ROCK YELLOW		3	8	10. Screen: Manufacturer's name JESSY HOWELL Type 5 Dia. 5 Slot/gauze 1/4 Length 20 Set between 117 ft. and 137 ft. Gravel pack? <input type="checkbox"/> Size range of material ft.		
ROCK WHITE		8	20	11. Static water level: 50 ft. below land surface Date 9-22-80		
ROCK YELLOW		20	25	12. Pumping level below land surfaces: after 1 hr. 50 ft. after 1 hrs. pumping 50 g.p.m. 50 ft. after 1 hrs. pumping 50 g.p.m. Estimated maximum yield 50 g.p.m.		
SHALE BLUE		25	33	13. Water sample submitted: Yes <input checked="" type="checkbox"/> No <input type="checkbox"/> Date 9-22-80		
SHALE RED		33	50	14. Well head completion: X Pitless adapter 18 inches above grade		
SHALE BLUE		60	65	15. Well grouted? X With: X Neat cement <input type="checkbox"/> Bentonite <input type="checkbox"/> Concrete <input type="checkbox"/> Depth: From 0 ft. to 15 ft.		
SHALE RED		80	90	16. Nearest source of possible contamination: ft. 30 Direction N Type 5 TANK Well disinfected upon completion? X Yes <input type="checkbox"/> No <input type="checkbox"/>		
SHALE BLUE		110	120	17. Pump: <input type="checkbox"/> Not installed Manufacturer's name DMPC Model number HP 1/2 Volts 230 Length of drop pipe 125 ft. capacity g.p.m. Type: <input checked="" type="checkbox"/> Submersible <input type="checkbox"/> Turbine <input type="checkbox"/> Jet <input type="checkbox"/> Reciprocating <input type="checkbox"/> Centrifugal <input type="checkbox"/> Other		
LIME ROCK GRAY		120	125	20. Water well contractor's certification: This well was drilled under my jurisdiction and this report is true to the best of my knowledge and belief. L.H. HRAVESHOP 156 Business name 13500 N PEIRY C9 License No. Address 7-7-81 Date Signed L.H. HRAVESHOP Authorized representative		
LIME ROCK WHITE		125	137			
(Use a second sheet if needed)						
18. Elevation:		19. Remarks:				
Topography: <input checked="" type="checkbox"/> Hill TO WEST <input type="checkbox"/> Slope <input type="checkbox"/> Upland <input type="checkbox"/> Valley						

Forward the white, blue and pink copies to the Department of Health and Environment

Form WWC-5