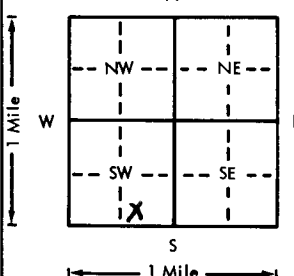
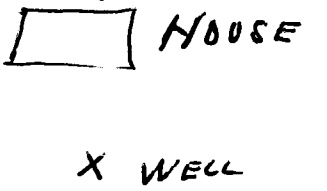


USE TYPEWRITER OR BALL  
POINT PEN-PRESS FIRMLY,  
PRINT CLEARLY.

WATER WELL RECORD  
KSA 82a-1201-1215

Kansas Department of Health and  
Environment-Division of Environment  
(Water well Contractors)  
Topeka, Kansas 66620

1. Location of well:		County <b>MORRIS</b>	Fraction <b>SW 1/4 SE 1/4 SW 1/4</b>	Section number <b>7</b>	Township number <b>T 16 S</b>	Range number <b>R 8 E</b>
2. Distance and direction from nearest town or city: <b>4 W</b>		3. Owner of well: <b>DONALD E WELLS G 3 CITYLINE</b>				
Street address of well location if in city: <b>OF COUNCIL GROVE</b>		R.R. or street: <b>18 WILLOW DELL</b> City, state, zip code: <b>MULVANEY KS 67110</b>				
4. Locate with "X" in section below:		Sketch map:				
						
5. Type and color of material		From	To	6. Bore hole dia. <b>9</b> in. Completion date <b>7-3-80</b> Well depth <b>139</b> ft.		
<b>BLACK DIRT + GRAVEL</b>		<b>0</b>	<b>3</b>	7. <input checked="" type="checkbox"/> Cable tool <input type="checkbox"/> Rotary <input type="checkbox"/> Driven <input type="checkbox"/> Dug <input type="checkbox"/> Hollow rod <input type="checkbox"/> Jetted <input type="checkbox"/> Bored <input type="checkbox"/> Reverse rotary		
<b>ROCK WHITE + YELLOW</b>		<b>3</b>	<b>30</b>	8. Use: <input checked="" type="checkbox"/> Domestic <input type="checkbox"/> Public supply <input type="checkbox"/> Industry <input type="checkbox"/> Irrigation <input type="checkbox"/> Air conditioning <input type="checkbox"/> Stock <input type="checkbox"/> Lawn <input type="checkbox"/> Oil field water <input type="checkbox"/> Other		
<b>SHALE BLUE</b>		<b>30</b>	<b>40</b>	9. Casing: Material <b>STEEL</b> Height: <input checked="" type="checkbox"/> Above or below Threaded <input type="checkbox"/> Welded <input type="checkbox"/> Surface <b>20</b> in. RMP <input type="checkbox"/> PVC <input type="checkbox"/> Weight <input type="checkbox"/> lbs./ft. Dia. <b>5</b> in. to <b>120</b> ft. depth Wall Thickness: inches or <b>0.208</b> Dia. <input type="checkbox"/> in. to <input type="checkbox"/> ft. depth gage No. <b>10208</b>		
<b>SHALE RED</b>		<b>40</b>	<b>52</b>	10. Screen: Manufacturer's name <b>JESSY LAWE</b> Type <input type="checkbox"/> Dia. <b>5</b> Slot/gauze <b>1/4</b> Length <b>139</b> ft. Set between <b>120</b> ft. and <b>139</b> ft. Gravel pack? <input type="checkbox"/> Size range of material <input type="checkbox"/>		
<b>SHALE BLUE</b>		<b>52</b>	<b>64</b>	11. Static water level: <input type="checkbox"/> mo./day/yr. <b>20</b> ft. below land surface Date <input type="checkbox"/>		
<b>LIME ROCK GRAY</b>		<b>64</b>	<b>75</b>	12. Pumping level below land surfaces: <input type="checkbox"/> ft. after <input type="checkbox"/> hrs. pumping <input type="checkbox"/> g.p.m. <input type="checkbox"/> ft. after <input type="checkbox"/> hrs. pumping <input type="checkbox"/> g.p.m. Estimated maximum yield <b>HALF FULL BAILING</b>		
<b>SHALE BLUE</b>		<b>75</b>	<b>98</b>	13. Water sample submitted: <input type="checkbox"/> mo./day/yr. <input type="checkbox"/> Yes <input checked="" type="checkbox"/> No Date <input type="checkbox"/>		
<b>ROCK GRAY</b>		<b>98</b>	<b>110</b>	14. Well head completion: <input checked="" type="checkbox"/> Pitless adapter <b>20</b> inches above grade		
<b>SHALE BLUE</b>		<b>110</b>	<b>122</b>	15. Well grouted? <input checked="" type="checkbox"/> With: <input checked="" type="checkbox"/> Neat cement <input type="checkbox"/> Bentonite <input type="checkbox"/> Concrete Depth: From <b>0</b> ft. to <b>15</b> ft.		
<b>ROCK GRAY</b>		<b>122</b>	<b>130</b>	16. Nearest source of possible contamination: ft. <b>50</b> Direction <b>N</b> Type <b>TANK</b> Well disinfected upon completion? <input checked="" type="checkbox"/> Yes <input type="checkbox"/> No		
<b>LIME ROCK WHITE</b>		<b>130</b>	<b>139</b>	17. Pump: Manufacturer's name <b>PUMPS</b> Model number <input type="checkbox"/> HP <b>1/2</b> Volts <b>220</b> Length of drop pipe <b>125</b> ft. capacity <input type="checkbox"/> g.p.m. Type: <input checked="" type="checkbox"/> Submersible <input type="checkbox"/> Turbine <input type="checkbox"/> Jet <input type="checkbox"/> Reciprocating <input type="checkbox"/> Centrifugal <input type="checkbox"/> Other		
18. Elevation:		19. Remarks:		20. Water well contractor's certification: This well was drilled under my jurisdiction and this report is true to the best of my knowledge and belief. <b>L.H. HRAUSE SHOP 156</b> Business name <b>13 SOUTH BELLEVUE 64</b> License No. Address <b>SALES</b> Signed <b>SALES</b> Date <b>7-7-80</b> Authorized representative		

Forward the white, blue and pink copies to the Department of Health and Environment

Form WWC-5