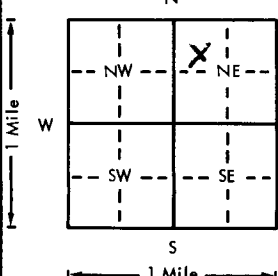
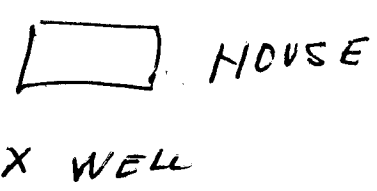


USE TYPEWRITER OR BALL
POINT PEN-PRESS FIRMLY,
PRINT CLEARLY.

WATER WELL RECORD
KSA 82a-1201-1215

Kansas Department of Health and
Environment-Division of Environment
(Water well Contractors)
Topeka, Kansas 66620

SEC C C12 COUNCIL GROVE LAKE

1. Location of well:	County MORRIS	Fraction S 1/4 NW 1/4 NE 1/4	Section number 7	Township number T 16 S R 8 E	Range number 8
2. Distance and direction from nearest town or city: 5 N, WEST		3. Owner of well: HARRY BARKLEY HEYNER R.R. or street: 3924 Sd SENECA P 524-4506 City, state, zip code: WICHITA KS 67217			
4. Locate with "X" in section below: 		Sketch map: 		6. Bore hole dia. 9 in. Completion date Well depth 132 ft. 7-25-1981	
5. Type and color of material		From	To	7. <input checked="" type="checkbox"/> Cable tool <input type="checkbox"/> Rotary <input type="checkbox"/> Driven <input type="checkbox"/> Dug <input type="checkbox"/> Hollow rod <input type="checkbox"/> Jetted <input type="checkbox"/> Bored <input type="checkbox"/> Reverse rotary	
DIRT & GRAVEL		0	3	8. Use: <input checked="" type="checkbox"/> Domestic <input type="checkbox"/> Public supply <input type="checkbox"/> Industry <input type="checkbox"/> Irrigation <input type="checkbox"/> Air conditioning <input type="checkbox"/> Stock <input type="checkbox"/> Lawn <input type="checkbox"/> Oil field water <input type="checkbox"/> Other	
ROCK YELLOW		3	28	9. Casing: Material PVC Height Above or below Threaded <input type="checkbox"/> Welded <input type="checkbox"/> Surface 30 in. RMP <input type="checkbox"/> PVC <input type="checkbox"/> Weight <input type="checkbox"/> lbs./ft. Dia. 5 in. to 112 ft. depth Wall Thickness: inches or Dia. <input type="checkbox"/> in. to <input type="checkbox"/> ft. depth gage No. 230	
SHALE BLUE		28	35	10. Screen: Manufacturer's name PUMPCo Type PVC Dia. 5 Slot/gauze 1/16 Length 20 Set between 117 ft. and 137 ft. ft. and <input type="checkbox"/> ft. Gravel pack? <input type="checkbox"/> Size range of material <input type="checkbox"/>	
SHALE RED		35	42	11. Static water level: <input type="checkbox"/> mo./day/yr. 50 ft. below land surface Date 7-25-1981	
LIME ROCK		42	45	12. Pumping level below land surfaces: <input type="checkbox"/> ft. after <input type="checkbox"/> hrs. pumping <input type="checkbox"/> g.p.m. <input type="checkbox"/> ft. after <input type="checkbox"/> hrs. pumping <input type="checkbox"/> g.p.m. Estimated maximum yield <input type="checkbox"/> g.p.m.	
SHALE BLUE		45	75	13. Water sample submitted: <input type="checkbox"/> mo./day/yr. Yes <input checked="" type="checkbox"/> No <input type="checkbox"/> Date <input type="checkbox"/>	
LIME GRAY		75	105	14. Well head completion: <input checked="" type="checkbox"/> Pitless adapter 20 Inches above grade	
SHALE BLUE		105	120	15. Well grouted? <input checked="" type="checkbox"/> With: <input checked="" type="checkbox"/> Neat cement <input type="checkbox"/> Bentonite <input type="checkbox"/> Concrete Depth: From 0 ft. to 15 ft.	
LIME ROCK WHITE		120	137	16. Nearest source of possible contamination: ft. SE Direction <input type="checkbox"/> Type <input type="checkbox"/> Well disinfected upon completion? <input checked="" type="checkbox"/> Yes <input type="checkbox"/> No	
(Use a second sheet if needed)				17. Pump: <input type="checkbox"/> Not installed Manufacturer's name PUMPCo Model number 305446 HP 1/2 Volts 230 Length of drop pipe 130 ft. capacity <input type="checkbox"/> g.p.m. Type: <input checked="" type="checkbox"/> Submersible <input type="checkbox"/> Turbine <input type="checkbox"/> Jet <input type="checkbox"/> Reciprocating <input type="checkbox"/> Centrifugal <input type="checkbox"/> Other	
18. Elevation:	19. Remarks:		20. Water well contractor's certification: This well was drilled under my jurisdiction and this report is true to the best of my knowledge and belief. L.H. HMAUSE SHOP 156 Business name 13 SOUTH BERRY ST License No. <input type="checkbox"/> Address 8-22 Signed L.H. HMAUSE Authorized representative Date 8-22		

Forward the white, blue and pink copies to the Department of Health and Environment

Form WWC-5