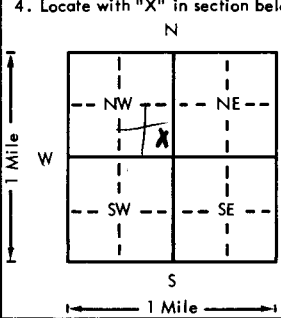
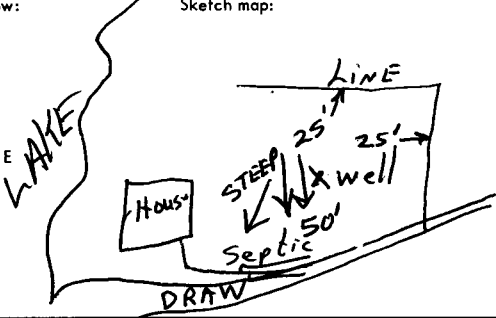


USE TYPEWRITER OR BALL
POINT PEN-PRESS FIRMLY,
PRINT CLEARLY.

WATER WELL RECORD
KSA 82a-1201-1215

Kansas Department of Health and
Environment-Division of Environment
(Water well Contractors)
Topeka, Kansas 66620

1. Location of well:		County Morris	Fraction SE 1/4 SE 1/4 NW 1/4	Section number 8	Township number T 16 S	Range number R 8 E
2. Distance and direction from nearest town or city: 1 mile N of Council Grove			3. Owner of well: John Honas R.R. or street: Council Grove Lake City, state, zip code:			
4. Locate with "X" in section below:		Sketch map:		6. Bore hole dia. 6 1/4 in. Completion date 7-8-77 Well depth 50 ft.		
				7. <input checked="" type="checkbox"/> Cable tool <input type="checkbox"/> Rotary <input type="checkbox"/> Driven <input type="checkbox"/> Dug <input type="checkbox"/> Hollow rod <input type="checkbox"/> Jetted <input type="checkbox"/> Bored <input type="checkbox"/> Reverse rotary		
5. Type and color of material		From	To	8. Use: <input checked="" type="checkbox"/> Domestic <input type="checkbox"/> Public supply <input type="checkbox"/> Industry <input type="checkbox"/> Irrigation <input type="checkbox"/> Air conditioning <input type="checkbox"/> Stock <input type="checkbox"/> Lawn <input type="checkbox"/> Oil field water <input type="checkbox"/> Other		
Gravel - Flint-Blue		0	2	9. Casing: Material PIES Height: (Above or below) Threaded <input type="checkbox"/> Welded glw Surface 20 in. RMP <input checked="" type="checkbox"/> PVC <input type="checkbox"/> Weight <input type="checkbox"/> lbs./ft.		
Clay - Brn		2	6	Dia. 5 in. to 30 ft. depth Wall Thickness: inches or Dia. <input type="checkbox"/> in. to <input type="checkbox"/> ft. depth gage No. 200		
LIME Broken - Yel		6	10	10. Screen: Manufacturer's name Sunflower Type RMP Dia. 5" Slot/gauze 1/8 Length 20' Set between 30 ft. and 50 ft. Gravel pack? <input checked="" type="checkbox"/> Size range of material 1/4-1/2		
Shale - Yel		10	15	11. Static water level: <input type="checkbox"/> mo./day/yr. 20 ft. below land surface Date 7-8-77		
Red Rock- Red		15	20	12. Pumping level below land surfaces: ____ ft. after ____ hrs. pumping ____ g.p.m. ____ ft. after ____ hrs. pumping ____ g.p.m. Estimated maximum yield 4 g.p.m.		
Red Rock- Lighter Red & softer		20	24	13. Water sample submitted: <input type="checkbox"/> Yes <input checked="" type="checkbox"/> No Date ____		
LIME - Wht		24	26	14. Well head completion: <input checked="" type="checkbox"/> Pitless adapter ____ Inches above grade		
Shale & Broken LIME Gray 30 H2O		26	34	15. Well grouted? Yes With: ____ Neat cement ____ Bentonite <input checked="" type="checkbox"/> Concrete Depth: From 3 ft. to 15 ft.		
LIME - Gray		34	39	16. Nearest source of possible contamination: ft. 50 Direction S Type Septic Well disinfected upon completion? <input checked="" type="checkbox"/> Yes <input type="checkbox"/> No		
Shale - Blue		39	42	17. Pump: <input type="checkbox"/> Not installed Manufacturer's name Gould Model number 7EH HP 1/2 Volts 230 Length of drop pipe 47 ft. capacity 10 g.p.m. Type: <input checked="" type="checkbox"/> Submersible <input type="checkbox"/> Turbine <input type="checkbox"/> Jet <input type="checkbox"/> Reciprocating <input type="checkbox"/> Centrifugal <input type="checkbox"/> Other		
LIME - Gray		42	47			
Shale Gray		47	49			
LIME/Blue Flint		49	50			
(Use a second sheet if needed)						
18. Elevation:		19. Remarks:		20. Water well contractor's certification: This well was drilled under my jurisdiction and this report is true to the best of my knowledge and belief. Zinn Water Well Drilling 218 Business name Address East Springs, Kan License No. ____ Signed Joseph A. Zinn Date 7-22-77 Authorized representative		
Topography: <input checked="" type="checkbox"/> Hill <input type="checkbox"/> Slope <input type="checkbox"/> Upland <input type="checkbox"/> Valley						

Forward the white, blue and pink copies to the Department of Health and Environment

Form WWC-5