USE TYPEWRITER OR BALL POINT PEN-PRESS FIRMLY, PRINT CLEARLY.

T R EW sec 1/4 1/4 1/4 No.

WATER WELL RECORD
KSA 82a-1201-1215

Kansas State Dept. Of Health
(Water Well Contractors)
Forbes-Bldg. 740
Topeka, Kansas 66620

1 Location of well:	County	Township name	Fraction	Section number	Town number	Range number
	MORRIS	[redacted]	NE¼ ~~NE¼~~	18	16	8E

Distance and direction from nearest town or city:

Street address of well location if in city: A/1

3 Owner of well: MIKE SAVINA
Address: 2603 ANIDON
WICHITA

Locate with "X" in section below:

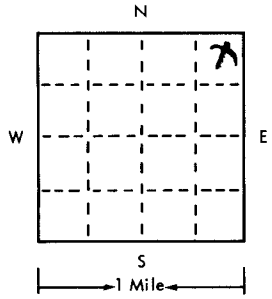

Sketch map:

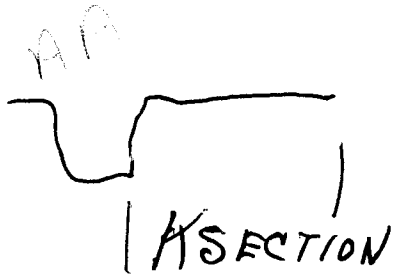

WEST ENTRANCE

4 Well depth: 60 ft. Date of completion 7-15-75
Well diameter 9 in.

5 [X] Cable tool [ ] Rotary [ ] Driven [ ] Dug
[ ] Hollow rod [ ] Jetted [ ] Bored [ ] Reverse rotary

6 Use: [X] Domestic [ ] Public supply [ ] Industry
[ ] Irrigation [ ] Air conditioning [ ] Commercial
[ ] Test well [ ] Aquaculture

7 Casing: Material STEEL Height above/below Surface 12 in.
Threaded [ ] Welded [ ]
Diam. Weight lbs./ft.
in. to ft. depth Drive shoe? [ ] Yes [ ] No
in. to ft. depth

2 Type and color of material	From	To
GRAVEL + DIRT	0	4
LIME ROCK YELLOW	4	28
SHALE BLUE	28	30
SHALE BLUE	30	38
SHALE RED	38	45
LIMEROCK YELLOW	45	50
SHALE BLUE	50	60
(use a second sheet if needed)		

8 Screen:
Manufacturer JESS + LOWELL
Type 200 Dia. 5
Slot/gauze SAWBLADE Length 20
Set between 40 ft. and 60 ft.
Fittings:
Gravel pack [ ] Yes [ ] No Size range of material

9 Static water level:
20 ft. below land surface Date

10 Pumping level below land surfaces:
ft. after hrs. pumping g.p.m.
ft. after hrs. pumping g.p.m.
Estimated maximum yield g.p.m.

11 Water sample submitted:
[ ] Yes [X] No Date

12 Well head completion:
[ ] Pitless adapter 12 inches above grade

13 Well grouted? [X] Yes [ ] No
[ ] Neat cement [ ] Bentonite [X] Concrete
Depth: From 0 ft. to 15 ft.

14 Nearest source of possible contamination:
ft. Direction Type
Well disinfected upon completion? [ ] Yes [ ] No

15 Pump: [X] Not installed
Manufacturer's name
Model number HP Volts
Length of drop pipe ft. capacity g.m.p.
Type:
[ ] Submersible [ ] Turbine
[ ] Jet [ ] Reciprocating
[ ] Certrifugal [ ] Other

16 Remarks: elevation

Topography:
[ ] Hill
[X] Slope To NORTH
[ ] Upland
[ ] Valley

17 Water well contractor's certification:
This well was drilled under my jurisdiction and this report is true to the best of my knowledge and belief.
L H KRAUSE 156A
Business name License No.
Address 13 SOUTH BELFRIS
Signed [signature] Date 7-29-75
Authorized representative

Forward the white, blue and pink copies to the Kansas State Dept. Of Health.

Form WWC-5

677-H