


1 LOCATION OF WATER WELL: County: MORRIS Fraction SE 1/4 SE 1/4 1/4 Section Number 19 Township Number T 16 S Range Number R 8 E/W

Distance and direction from nearest town or city street address of well if located within city?

SECRET CITY LAKE COUNCIL GROVE

2 WATER WELL OWNER: HARDY HAWLEY RR#, St. Address, Box #: 1053 PATRICIA Board of Agriculture, Division of Water Resources
City, State, ZIP Code: WICHITA KS 67208 Application Number:

3 LOCATE WELL'S LOCATION WITH AN "X" IN SECTION BOX: 4 DEPTH OF COMPLETED WELL 80 ft. ELEVATION:

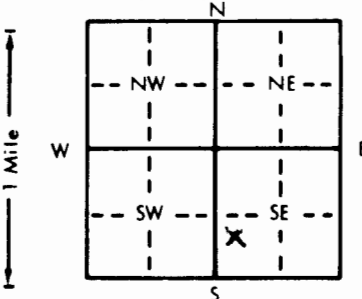

Depth(s) Groundwater Encountered 1. 30 ft. 2. ft. 3. ft.

WELL'S STATIC WATER LEVEL 15 ft. below land surface measured on mo/day/yr 9-15-82

Pump test data: Well water was ft. after hours pumping gpm

Est. Yield 1 gpm: Well water was ft. after hours pumping gpm

Bore Hole Diameter 8 in. to ft., and in. to ft.

WELL WATER TO BE USED AS: 5 Public water supply 8 Air conditioning 11 Injection well

(1) Domestic 3 Feedlot 6 Oil field water supply 9 Dewatering 12 Other (Specify below)

2 Irrigation 4 Industrial 7 Lawn and garden only 10 Observation well

Was a chemical/bacteriological sample submitted to Department? Yes No X; If yes, mo/day/yr sample was submitted Water Well Disinfected? Yes X No

5 TYPE OF BLANK CASING USED: 5 Wrought iron 8 Concrete tile CASING JOINTS: Glued X Clamped

1 Steel 3 RMP (SR)

(2) PVC 4 ABS

6 Asbestos-Cement

9 Other (specify below)

Welded

7 Fiberglass

Threaded

Blank casing diameter 5 in. to 30 ft., Dia 50 in. to 80 ft., Dia in. to ft.

Casing height above land surface 14 in., weight lbs./ft. Wall thickness or gauge No. 160

TYPE OF SCREEN OR PERFORATION MATERIAL:

1 Steel 3 Stainless steel

5 Fiberglass

(7) PVC

10 Asbestos-cement

2 Brass

4 Galvanized steel

6 Concrete tile

8 RMP (SR)

11 Other (specify)

1 Continuous slot

3 Mill slot

5 Gauzed wrapped

(8) Saw cut

11 None (open hole)

2 Louvered shutter

4 Key punched

6 Wire wrapped

9 Drilled holes

SCREEN OR PERFORATION OPENINGS ARE:

1 Continuous slot

3 Mill slot

6 Wire wrapped

9 Drilled holes

2 Louvered shutter

4 Key punched

6 Wire wrapped

9 Drilled holes

SCREEN-PERFORATED INTERVALS:

From 30 ft. to 50 ft., From ft. to ft.

From ft. to ft., From ft. to ft.

GRAVEL PACK INTERVALS: From ft. to ft., From ft. to ft.

From ft. to ft., From ft. to ft.

6 GROUT MATERIAL: (1) Neat cement 2 Cement grout 3 Bentonite 4 Other

Grout Intervals: From 0 ft. to 15 ft., From ft. to ft., From ft. to ft.

What is the nearest source of possible contamination:

(1) Septic tank

4 Lateral lines

7 Pit privy

10 Livestock pens

14 Abandoned water well

2 Sewer lines

5 Cess pool

8 Sewage lagoon

11 Fuel storage

15 Oil well/Gas well

3 Watertight sewer lines

6 Seepage pit

9 Feedyard

12 Fertilizer storage

16 Other (specify below)

Direction from well?

SOUTH

How many feet?

50

FROM	TO	LITHOLOGIC LOG	FROM	TO	LITHOLOGIC LOG
0	3	BLACK DIRT			
3	20	LIME ROCK YELLOW			
20	35	LIME ROCK GRAY			
35	48	SHALE BLUE			
48	65	LIME ROCK GRAY			
65	69	SHALE BLUE			
69	75	SHALE RED			
75	80	LIME ROCK GRAY			

7 CONTRACTOR'S OR LANDOWNER'S CERTIFICATION: This water well was (1) constructed, (2) reconstructed, or (3) plugged under my jurisdiction and was completed on (mo/day/year) 9-15-82 and this record is true to the best of my knowledge and belief. Kansas

Water Well Contractor's License No. 156 This Water Well Record was completed on (mo/day/yr) 10-12-82

under the business name of LHMBRAUSESHOP by (signature) [Signature]

INSTRUCTIONS: Use typewriter or ball point pen, PLEASE PRESS FIRMLY and PRINT clearly. Please fill in blanks, underline or circle the correct answers. Send top three copies to Kansas Department of Health and Environment, Division of Environment, Environmental Geology Section, Topeka, KS 66620. Send one to WATER WELL OWNER and retain one for your records.

OFFICE USE ONLY

T

16

R

8

E/W

SEC.

7

SW 1/4

SE 1/4

1/4