


1 LOCATION OF WATER WELL: County: MORRIS Fraction SW 1/4 SE 1/4 1/4 Section Number 19 Township Number T 9-16 S Range Number R 8 EW

Distance and direction from nearest town or city street address of well if located within city?

SEC E 6 CITY LAKE COUNCIL GROVE

2 WATER WELL OWNER: LOYAL VINCENT
RR#, St. Address, Box #: 475 INMAN Board of Agriculture, Division of Water Resources
City, State, ZIP Code: KANSAS 67546 Application Number:

3 LOCATE WELL'S LOCATION WITH AN "X" IN SECTION BOX:

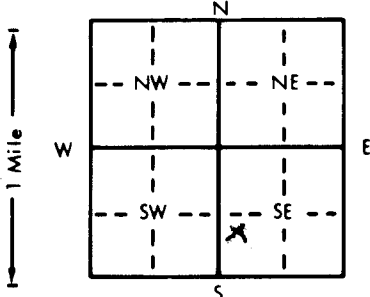

4 DEPTH OF COMPLETED WELL: 8.2 ft. ELEVATION:

Depth(s) Groundwater Encountered 1. 30 ft. 2. ft. 3. ft.

WELL'S STATIC WATER LEVEL 15 ft. below land surface measured on mo/day/yr 9-20-82

Pump test data: Well water was ft. after hours pumping gpm

Est. Yield 1 gpm: Well water was ft. after hours pumping gpm

Bore Hole Diameter 8 in. to ft. and in. to ft.

WELL WATER TO BE USED AS: 5 Public water supply 8 Air conditioning 11 Injection well

☒ Domestic 3 Feedlot 6 Oil field water supply 9 Dewatering 12 Other (Specify below)

2 Irrigation 4 Industrial 7 Lawn and garden only 10 Observation well

Was a chemical/bacteriological sample submitted to Department? Yes.....No ☒.....; If yes, mo/day/yr sample was submitted

Water Well Disinfected? Yes ☒ No

5 TYPE OF BLANK CASING USED: 1 Steel 3 RMP (SR) 5 Wrought iron 8 Concrete tile CASING JOINTS: Glued ☒ Clamped

☒ PVC 4 ABS 6 Asbestos-Cement 9 Other (specify below) Welded

Blank casing diameter 5 in. to 25 ft., Dia 45 in. to 8.2 ft., Dia in. to ft.

Casing height above land surface 1.6 in., weight lbs./ft. Wall thickness or gauge No. 160

TYPE OF SCREEN OR PERFORATION MATERIAL: ☒ PVC 10 Asbestos-cement

1 Steel 3 Stainless steel 5 Fiberglass 8 RMP (SR) 11 Other (specify)

2 Brass 4 Galvanized steel 6 Concrete tile 9 ABS 12 None used (open hole)

SCREEN OR PERFORATION OPENINGS ARE: 5 Gauzed wrapped ☒ Saw cut 11 None (open hole)

1 Continuous slot 3 Mill slot 6 Wire wrapped 9 Drilled holes

2 Louvered shutter 4 Key punched 7 Torch cut 10 Other (specify)

SCREEN-PERFORATED INTERVALS: From 2.5 ft. to 4.5 ft., From ft. to ft.

From ft. to ft., From ft. to ft.

GRAVEL PACK INTERVALS: From ft. to ft., From ft. to ft.

From ft. to ft., From ft. to ft.

6 GROUT MATERIAL: ☒ Neat cement 2 Cement grout 3 Bentonite 4 Other

Grout Intervals: From 0 ft. to 15 ft., From ft. to ft., From ft. to ft.

What is the nearest source of possible contamination: 10 Livestock pens 14 Abandoned water well

1 Septic tank 4 Lateral lines 7 Pit privy 11 Fuel storage 15 Oil well/Gas well

2 Sewer lines 5 Cess pool 8 Sewage lagoon 12 Fertilizer storage 16 Other (specify below)

3 Watertight sewer lines 6 Seepage pit 9 Feedyard 13 Insecticide storage

Direction from well? SE How many feet?

FROM	TO	LITHOLOGIC LOG	FROM	TO	LITHOLOGIC LOG
<u>0</u>	<u>3</u>	<u>DIRT</u>			
<u>3</u>	<u>20</u>	<u>ROCK YELLOW</u>			
<u>20</u>	<u>25</u>	<u>SHALE BLUE</u>			
<u>25</u>	<u>30</u>	<u>SHALE RED</u>			
<u>30</u>	<u>40</u>	<u>LIME ROCK W</u>			
<u>40</u>	<u>50</u>	<u>SHALE BLUE</u>			
<u>50</u>	<u>65</u>	<u>LIME ROCK GRAY</u>			
<u>65</u>	<u>73</u>	<u>SHALE BLUE</u>			
<u>73</u>	<u>75</u>	<u>LIME ROCK GRAY</u>			
<u>75</u>	<u>82</u>	<u>SHALE DARK</u>			

7 CONTRACTOR'S OR LANDOWNER'S CERTIFICATION: This water well was (1) constructed, (2) reconstructed, or (3) plugged under my jurisdiction and was completed on (mo/day/year) 9-20-82 and this record is true to the best of my knowledge and belief. Kansas

Water Well Contractor's License No. 156 This Water Well Record was completed on (mo/day/yr) 10-12-82

under the business name of ELMERALSE SHUP by (signature) ELMERALSE SHUP

INSTRUCTIONS: Use typewriter or ball point pen, PLEASE PRESS FIRMLY and PRINT clearly. Please fill in blanks, underline or circle the correct answers. Send top three copies to Kansas Department of Health and Environment, Division of Environment, Environmental Geology Section, Topeka, KS 66620. Send one to WATER WELL OWNER and retain one for your records.

OFFICE USE ONLY

T

16

R

8

EW

SEC.

19

SW 1/4 SE 1/4

1/4