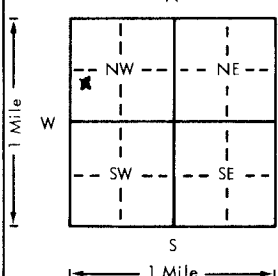
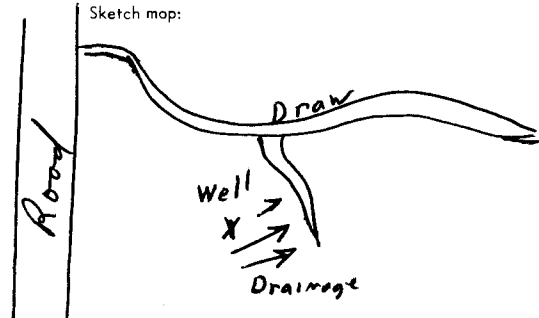


USE TYPEWRITER OR BALL
POINT PEN-PRESS FIRMLY,
PRINT CLEARLY.

WATER WELL RECORD
KSA 82a-1201-1215

Kansas Department of Health and
Environment-Division of Environment
(Water well Contractors)
Topeka, Kansas 66620

1. Location of well:		County Morris	Fraction NW 1/4 SW 1/4 NW 1/4	Section number 21	Township number T 16 S	Range number R 8 E
2. Distance and direction from nearest town or city: West 1/2 mile South of Council Grove		3. Owner of well: Larry Bachura R.R. or street: RR1 City, state, zip code: Council Grove, KS				
4. Locate with "X" in section below: 		Sketch map: 		6. Bore hole dia. 6 3/4 in. Completion date 8-24-78 Well depth 81 ft.		
5. Type and color of material		From	To	7. <input type="checkbox"/> Cable tool <input checked="" type="checkbox"/> Rotary <input type="checkbox"/> Driven <input type="checkbox"/> Dug <input type="checkbox"/> Hollow rod <input type="checkbox"/> Jetted <input type="checkbox"/> Bored <input type="checkbox"/> Reverse rotary		
Topsoil - Bk		0	2	8. Use: <input checked="" type="checkbox"/> Domestic <input type="checkbox"/> Public supply <input type="checkbox"/> Industry <input type="checkbox"/> Irrigation <input type="checkbox"/> Air conditioning <input type="checkbox"/> Stock <input type="checkbox"/> Lawn <input type="checkbox"/> Oil field water <input type="checkbox"/> Other		
Flint Gravel		2	5	9. Casing: Material P16s Height: Above or below Threading Welded Surface 18 in. RMP <input checked="" type="checkbox"/> PVC alu Weight 18 lbs./ft. Dia. 5 in. to 40 ft. depth Wall Thickness: inches or Dia. 5 in. to 40 ft. depth gauge No. 200		
Shale - Yel		5	8	10. Screen: Manufacturer's name Sunflower Type RMP Dia. 5" Slot/gauze 1/8 Length 40 Set between 41 ft. and 81 ft. Gravel pack? NO Size range of material		
Lime - Yel		8	12	11. Static water level: 40 ft. below land surface Date 8-24-78 mo./day/yr.		
Shale - Yel		12	18	12. Pumping level below land surfaces: ____ ft. after ____ hrs. pumping ____ g.p.m. ____ ft. after ____ hrs. pumping ____ g.p.m. Estimated maximum yield 5-7 g.p.m.		
Lime - Yel		18	21	13. Water sample submitted: ____ mo./day/yr. Yes <input checked="" type="checkbox"/> No <input type="checkbox"/> Date		
Shale - Gray		21	23	14. Well head completion: <input type="checkbox"/> Pitless adapter 18 inches above grade		
Lime - Gray		23	24	15. Well grouted? Yes With: <input checked="" type="checkbox"/> Neat cement <input type="checkbox"/> Bentonite <input type="checkbox"/> Concrete Depth: From 3 ft. to 13 ft.		
Red Rock		24	27	16. Nearest source of possible contamination: ft. 60 Direction NE Type Drainage Well disinfected upon completion? <input checked="" type="checkbox"/> Yes <input type="checkbox"/> No		
Lime - TAN		27	29	17. Pump: <input checked="" type="checkbox"/> Not installed Manufacturer's name Model number ____ HP ____ Volts ____ Length of drop pipe ____ ft. capacity ____ g.p.m. Type: <input type="checkbox"/> Submersible <input type="checkbox"/> Turbine <input type="checkbox"/> Jet <input type="checkbox"/> Reciprocating <input type="checkbox"/> Centrifugal <input type="checkbox"/> Other		
Shale - Lite Blue		29	32	20. Water well contractor's certification: This well was drilled under my jurisdiction and this report is true to the best of my knowledge and belief. Zinn Water Well Drilling 218 Business name Lost Springs, KS. License No. Address Joseph A. Zinn Date 8-27-78 Signed Joseph A. Zinn Authorized representative		
Lime with Layers of Blue Flint		32	41			
Broken - Water		41	42			
Lime with mostly Blue Flint		42	48			
Shale Gray		48	49			
Lime - Iron Gray		49	52			
Shale - Gray		52	53			
Lime with Layers of Flint - TAN (Gears)		53	81			
(Use a second sheet if needed)						
18. Elevation: Topography: <input type="checkbox"/> Hill <input checked="" type="checkbox"/> Slope <input type="checkbox"/> Upland <input type="checkbox"/> Valley	19. Remarks:					

Forward the white, blue and pink copies to the Department of Health and Environment

Form WWC-5