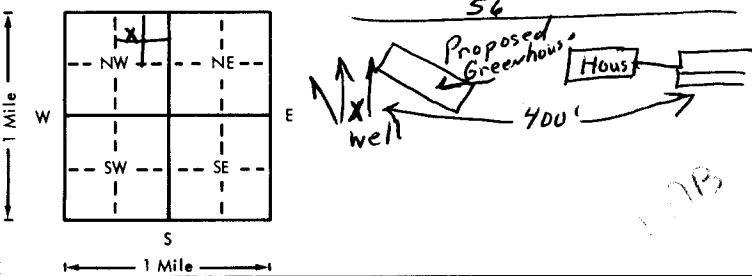


USE TYPEWRITER OR BALL  
POINT PEN-PRESS FIRMLY,  
PRINT CLEARLY.

WATER WELL RECORD  
KSA 82a-1201-1215

Kansas Department of Health and  
Environment-Division of Environment  
(Water well Contractors)  
Topeka, Kansas 66620

1. Location of well:		County <b>Morris</b>	Fraction <b>NW 1/4 NE 1/4 NW 1/4</b>	Section number <b>21</b>	Township number <b>T 16 S</b>	Range number <b>R 8 E/W</b>
2. Distance and direction from nearest town or city: <b>1/2 mile west of Council Grove</b>			3. Owner of well: <b>Wayne Barnett</b> R.R. or street: <b>Rt 1</b> City, state, zip code: <b>Council Grove Kan</b>			
4. Locate with "X" in section below:		Sketch map:		6. Bore hole dia. <b>6 1/2</b> in. Completion date <b>6-15-76</b> Well depth <b>65</b> ft.		
				7. <input checked="" type="checkbox"/> Cable tool <input type="checkbox"/> Rotary <input type="checkbox"/> Driven <input type="checkbox"/> Dug <input type="checkbox"/> Hollow rod <input type="checkbox"/> Jetted <input type="checkbox"/> Bored <input type="checkbox"/> Reverse rotary		
5. Type and color of material		From	To	8. Use: <input checked="" type="checkbox"/> Domestic <input type="checkbox"/> Public supply <input type="checkbox"/> Industry <input checked="" type="checkbox"/> Irrigation <input type="checkbox"/> Air conditioning <input type="checkbox"/> Stock <input checked="" type="checkbox"/> Lawn <input type="checkbox"/> Oil field water <input type="checkbox"/> Other		
Topsoil		0	1	9. Casing: Material <b>ALCS</b> Height <b>Above</b> or below Threaded <input type="checkbox"/> Welded <input checked="" type="checkbox"/> Surface <b>18</b> in. RMP <input type="checkbox"/> PVC <input checked="" type="checkbox"/> Weight <input type="checkbox"/> lbs./ft. Dia. <b>5</b> in. to <b>25</b> ft. depth Wall Thickness: inches or Dia. <input type="checkbox"/> in. to <input type="checkbox"/> ft. depth gage No. <b>200</b>		
Shale - Yel		1	6	10. Screen: Manufacturer's name <b>Sunflower</b> Type <b>RMP</b> Dia. <b>5"</b> Slot/gauze <b>YB</b> Length <b>40'</b> Set between <b>25</b> ft. and <b>65</b> ft. ft. and <input type="checkbox"/> ft. Gravel pack? <b>NO</b> Size range of material <input type="checkbox"/>		
Red Rock		6	11	11. Static water level: <input type="checkbox"/> mo./day/yr. <b>25</b> ft. below land surface Date <b>6-15-76</b>		
Lime - wht		11	24	12. Pumping level below land surfaces: <input type="checkbox"/> ft. after <input type="checkbox"/> hrs. pumping <input type="checkbox"/> g.p.m. <input type="checkbox"/> ft. after <input type="checkbox"/> hrs. pumping <input type="checkbox"/> g.p.m. Estimated maximum yield <b>Y4</b> g.p.m.		
Shale - Lite Gray		24	25	13. Water sample submitted: <input type="checkbox"/> Yes <input checked="" type="checkbox"/> No Date <input type="checkbox"/>		
Lime - Gray		25	37	14. Well head completion: <input type="checkbox"/> Pitless adapter <b>18</b> inches above grade		
Shale - Blu		37	41	15. Well grouted? <b>Yes</b> With: <input type="checkbox"/> Neat cement <input type="checkbox"/> Bentonite <input checked="" type="checkbox"/> Concrete Depth: From <b>3</b> ft. to <b>13</b> ft.		
Lime - Gray Abrassive		41	46	16. Nearest source of possible contamination: ft. <b>400</b> Direction <b>E</b> Type <b>Septic</b> Well disinfected upon completion? <input checked="" type="checkbox"/> Yes <input type="checkbox"/> No		
Shale - Gray		46	48	17. Pump: <input checked="" type="checkbox"/> Not installed		
Lime - Gray Abrassive		48	55	Manufacturer's name <input type="checkbox"/> Model number <input type="checkbox"/> HP <input type="checkbox"/> Volts <input type="checkbox"/> Length of drop pipe <input type="checkbox"/> ft. capacity <input type="checkbox"/> g.p.m. Type: <input type="checkbox"/> Submersible <input type="checkbox"/> Turbine <input type="checkbox"/> Jet <input type="checkbox"/> Reciprocating <input type="checkbox"/> Centrifugal <input type="checkbox"/> Other		
Shale - Gray		55	57	20. Water well contractor's certification: This well was drilled under my jurisdiction and this report is true to the best of my knowledge and belief. <b>Zinn Water Well Drilling 218</b> Business name <input type="checkbox"/> License No. <input type="checkbox"/> Address <b>East Springs, Kan</b> Signed <b>Joseph A. Zinn</b> Date <b>7-5-76</b> Authorized representative		
Lime - Gray Abrassive		57	63			
Shale - Blu		63	65			
(Use a second sheet if needed)						
18. Elevation:		19. Remarks: <b>Concrete slab 4'x4'x4" to be installed by customer</b> <b>X Wayne Barnett</b>				
Topography: <input type="checkbox"/> Hill <input checked="" type="checkbox"/> Slope <input type="checkbox"/> Upland <input type="checkbox"/> Valley						

Forward the white, blue and pink copies to the Department of Health and Environment

Form WWC-5