

WATER WELL PLUGGING RECORD Form WWC-5P

KSA 82a-1212

ID NO.

MW-8

1 LOCATION OF WATER WELL:

Morris County

Fraction

NE ¼ SW ¼ NW ¼

Section Number

13

Township Number

16 S

Range Number

R 8 E

Distance and direction from nearest town or city street address of well if located within city?

Well was located at 611 E. Main, Council Grove, Kansas

2 WATER WELL OWNER:

Williams Fertilizer

RR#, St. Address, Box #:

611 E. Main

City, State ZIP Code:

Council Grove, KS 66846

Global Positioning Systems (decimal degrees, min. of 4 digits)

Latitude: _____


Longitude: _____

Elevation: _____

Datum: _____

Data Collection Method: _____

3 MARK WELL'S LOCATION WITH AN "X" IN SECTION BOX:

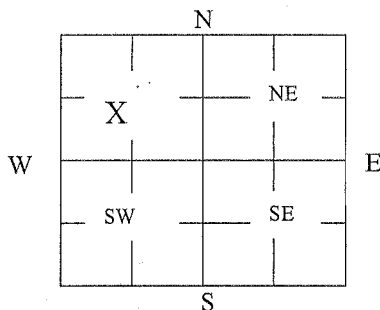

4 DEPTH OF WELL 17.19 ft.

WELL'S STATIC WATER LEVEL 12.18 ft

WELL WAS USED AS:

☒ X

1 Domestic

5 Public Water Supply

9 Dewatering

2 Irrigation

6 Oil Field Water Supply

☒ 10 Monitoring

3 Feedlot

7 Domestic (Lawn & Garden)

11 Injection Well

4 Industrial

8 Air Conditioning

12 Other _____

Was a chemical/bacteriological sample submitted to Department? Yes _____ No ☒ x

5 TYPE OF BLANK CASING USED:

1 Steel

3 RMP (SR)

5 Wrought

7 Fiberglass

9 Other (Specify below)

☒ 2 PVC

4 ABS

6 Asbestos-Cement

8 Concrete Tile

Blank casing diameter 2 in. Was casing pulled? Yes ☒ x No _____ If yes, how much 3'

Casing height above or below land surface _____ in.

6 GROUT PLUG MATERIAL:

1 Neat cement

2 Cement grout

3 Bentonite

4 Other Soil _____

Grout Plug Intervals: From 2 0 ft. to 0.5 ft., From 4 0.5 ft. to 3.5 ft., From 3 3.5 to 17.19 ft.

What is the nearest source of possible contamination:

1 Septic tank

6 Seepage pit

11 Fuel Storage

16 Other (specify below)

2 Sewer lines

7 Pit privy

12 Fertilizer storage

Contaminated Site _____

3 Watertight sewer lines

8 Sewage lagoon

13 Insecticide storage

4 Lateral lines

9 Feedyard

14 Abandoned water well

Direction from well? _____

5 Cess pool

10 Livestock pens

15 Oil well/Gas well

How many feet? _____

| FROM | TO | PLUGGING MATERIALS | FROM | TO | PLUGGING MATERIALS |
|------|--------|--------------------|------|----|--------------------|
| 0' | 0.5' | Gravel | | | |
| 0.5' | 3.5' | Soil | | | |
| 3.5' | 17.19' | Bentonite Chips | | | |
| | | | | | |
| | | | | | |
| | | | | | |
| | | | | | |

7 CONTRACTOR'S OR LANDOWNER'S CERTIFICATION:

This water well was plugged under my jurisdiction and was completed on (mo/day/year) 10/24/11 and this record is true to the best of my knowledge and belief. Kansas Water Well Contractor's License No. 585. This Water Well Record was completed on (mo/day/year) 10/27/11 under the business name of Associated Environmental, Inc. by (signature) *Barbara Johnson*

INSTRUCTIONS: Use typewriter or ballpoint pen. Please press firmly and print clearly. Please fill in blanks, underline or circle the correct answers. Send top three copies to Kansas Department of Health and Environment, Bureau of Water, Geology Section, 1000 SW Jackson St., Ste. 420, Topeka, Kansas 66612-1367. Telephone: 785/296-5522. Send one to Water Well Owner and retain one for your records. Visit us at <http://www.kdheks.gov/waterwell/index.html>.