


1 LOCATION OF WATER WELL:	Fraction	Section Number	Township Number	Range Number
County: <u>Merriam</u>	<u>SE</u> $\frac{1}{4}$ <u>SE</u> $\frac{1}{4}$ <u>SE</u> $\frac{1}{4}$	<u>11</u>	<u>T 16</u> <u>S</u>	<u>R 8</u> <u>EW</u>

Distance and direction from nearest town or city street address of well if located within city?

Soccer Field @ Fair Grounds

2 WATER WELL OWNER:	RR#, St. Address, Box #	City, State, ZIP Code	Board of Agriculture, Division of Water Resources
<u>Council Grove City</u>	<u>313 West Main</u> <u>Box 313</u>	<u>Council Grove</u> <u>Ks</u> <u>66846</u>	Application Number: <u>41129</u>

3 LOCATE WELL'S LOCATION WITH AN "X" IN SECTION BOX:	4 DEPTH OF COMPLETED WELL	ELEVATION:
--	---------------------------	------------

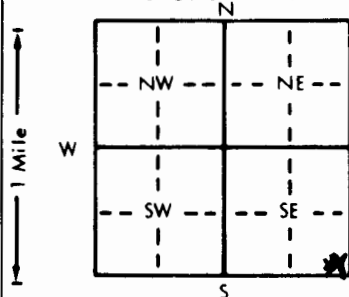

WELL'S STATIC WATER LEVEL	<u>4.5</u> ft. below land surface measured on mo/day/yr <u>Aug 5 94</u>		
Bore Hole Diameter	<u>8 7/8</u> in. to <u>17</u> ft., and <u>7</u> in. to <u>30</u> ft.		
WELL WATER TO BE USED AS:	5 Public water supply	8 Air conditioning	11 Injection well
	1 Domestic	3 Feedlot	6 Oil field water supply
	2 Irrigation	4 Industrial	7 Lawn and garden only
			10 Dewatering
			12 Other (Specify below)
Was a chemical/bacteriological sample submitted to Department?	Yes <u>X</u>	No <u>X</u>	If yes, mo/day/yr sample was submitted
			Water Well Disinfected? <u>Yes</u> <u>X</u> No

5 TYPE OF BLANK CASING USED:	5 Wrought iron	8 Concrete tile	CASING JOINTS: Glued <u>X</u> Clamped
1 Steel	3 RMP (SR)	6 Asbestos-Cement	9 Other (specify below)
2 PVC	4 ABS	7 Fiberglass	Welded
			Threaded

Casing height above land surface	<u>18</u> in., weight	lbs./ft. Wall thickness or gauge No. <u>SDR-26</u>	

TYPE OF SCREEN OR PERFORATION MATERIAL:	1 Steel	3 Stainless steel	5 Fiberglass	8 RMP (SR)	10 Asbestos-cement
	2 Brass	4 Galvanized steel	6 Concrete tile	9 ABS	11 Other (specify)
SCREEN OR PERFORATION OPENINGS ARE:	1 Continuous slot	3 Mill slot	5 Gauzed wrapped	8 Saw cut	11 None (open hole)
	2 Louvered shutter	4 Key punched	6 Wire wrapped	9 Drilled holes	
			7 Torch cut	10 Other (specify)	


What is the nearest source of possible contamination:	1 Septic tank	4 Lateral lines	7 Pit privy	10 Livestock pens
	2 Sewer lines	5 Cess pool	8 Sewage lagoon	11 Fuel storage
	3 Watertight sewer lines	6 Seepage pit	9 Feedyard	12 Fertilizer storage
				13 Insecticide storage
Direction from well?	<u>South</u>			How many feet? <u>52</u>

FROM	TO	LITHOLOGIC LOG	FROM	TO	PLUGGING INTERVALS
<u>0</u>	<u>3</u>	<u>Top Soil BLK</u>			
<u>3</u>	<u>15.5</u>	<u>Sandy Silt</u>			
<u>15.5</u>	<u>17</u>	<u>Gravel in Gray Silt</u>			
<u>17</u>	<u>21</u>	<u>LIME Gray</u>			
<u>21</u>	<u>25</u>	<u>Shale Blue Green</u>			
<u>25</u>	<u>30</u>	<u>LIME Lile TAN</u>			

7 CONTRACTOR'S OR LANDOWNER'S CERTIFICATION: This water well was (1) constructed, (2) reconstructed, or (3) plugged under my jurisdiction and was completed on (mo/day/year) <u>Aug 5 94</u> and this record is true to the best of my knowledge and belief. Kansas Water Well Contractor's License No. <u>218</u> This Water Well Record was completed on (mo/day/yr) <u>Aug 30 94</u> under the business name of <u>Zinn Water Well Drilling</u> by (signature) <u>Joseph A. Zinn</u>
