


1 LOCATION OF WATER WELL:	Fraction	Section Number	Township Number	Range Number
County: <u>Morris</u>	<u>SE 1/4 SE 1/4 SE 1/4</u>	<u>11</u>	<u>T 14 S</u>	<u>R 8 E/W</u>

Distance and direction from nearest town or city street address of well if located within city?

Soccer Field @ Fair Ground

2 WATER WELL OWNER:	RR#, St. Address, Box #	City, State, ZIP Code	Board of Agriculture, Division of Water Resources
<u>Council Grove City</u>	<u>313 West Main Box 313</u>	<u>Council Grove, KS 66846</u>	Application Number: <u>41129</u>

3 LOCATE WELL'S LOCATION WITH AN "X" IN SECTION BOX:	4 DEPTH OF COMPLETED WELL: <u>35</u> ft. ELEVATION:
--	---

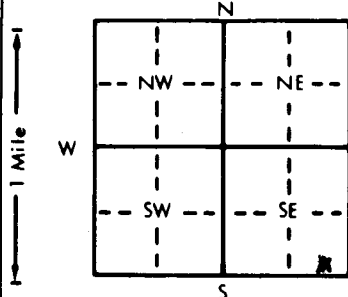

Depth(s) Groundwater Encountered 1. 10 ft. 2. 10 ft. 3. 10 ft.

WELL'S STATIC WATER LEVEL 4 ft. below land surface measured on mo/day/yr Aug 5 94

Air ~~test~~ test data: Well water was 32 ft. after 52 hours pumping 52 gpm

Est. Yield 32 gpm: Well water was 32 ft. after 52 hours pumping 52 gpm

Bore Hole Diameter 8 5/8 in. to 16 ft., and 7 1/2 in. to 35 ft.

WELL WATER TO BE USED AS:

5 Public water supply	8 Air conditioning	11 Injection well
1 Domestic	3 Feedlot	6 Oil field water supply
9 Dewatering	12 Other (Specify below)	
3 Irrigation	4 Industrial	7 Lawn and garden only
10 Monitoring well		

Was a chemical/bacteriological sample submitted to Department? Yes X No X; If yes, mo/day/yr sample was submitted

Water Well Disinfected? Yes X No X

5 TYPE OF BLANK CASING USED:	5 Wrought iron	8 Concrete tile	CASING JOINTS: Glued <u>X</u> Clamped
1 Steel	3 RMP (SR)	6 Asbestos-Cement	9 Other (specify below)
2 PVC	4 ABS	7 Fiberglass	Welded
Blank casing diameter <u>5</u> in. to <u>10</u> ft., Dia			Threaded
Casing height above land surface <u>18</u> in., weight			lbs./ft. Wall thickness or gauge No. <u>SDR-26</u>
TYPE OF SCREEN OR PERFORATION MATERIAL:			
1 Steel	3 Stainless steel	5 Fiberglass	8 RMP (SR)
2 Brass	4 Galvanized steel	6 Concrete tile	9 ABS
SCREEN OR PERFORATION OPENINGS ARE:			
1 Continuous slot	3 Mill slot	5 Gauzed wrapped	8 Saw cut
2 Louvered shutter	4 Key punched	6 Wire wrapped	11 None (open hole)
SCREEN-PERFORATED INTERVALS:			
From <u>10</u> ft. to <u>35</u> ft.			
GRAVEL PACK INTERVALS:			
From <u>10</u> ft. to <u>35</u> ft.			

6 GROUT MATERIAL:	1 Neat cement	2 Cement grout	3 Bentonite	4 Other
GROUT INTERVALS: From <u>3</u> ft. to <u>10</u> ft.				
What is the nearest source of possible contamination:				
1 Septic tank	4 Lateral lines	7 Pit privy	10 Livestock pens	14 Abandoned water well
2 Sewer lines	5 Cess pool	8 Sewage lagoon	11 Fuel storage	15 Oil well/Gas well
3 Watertight sewer lines	6 Seepage pit	9 Feedyard	12 Fertilizer storage	16 Other (specify below)
Direction from well? <u>South</u>			How many feet? <u>55</u>	<u>RAVINE</u>

FROM	TO	LITHOLOGIC LOG	FROM	TO	PLUGGING INTERVALS
0	5	Topsoil Blk			
5	10	SANDY Silt			
10	15	Gravel			
15	16	Shale Gray			
16	20	LIME Gray			
20	22.5	Shale Blue Green			
22.5	25	LIME Lite TAN			
25	28	Shale Green			
28	33	LIME Gray			
33	35	Shale DK Gray			

7 CONTRACTOR'S OR LANDOWNER'S CERTIFICATION: This water well was (1) constructed, (2) reconstructed, or (3) plugged under my jurisdiction and was completed on (mo/day/year) <u>Aug 30 94</u> and this record is true to the best of my knowledge and belief. Kansas Water Well Contractor's License No. <u>218</u> This Water Well Record was completed on (mo/day/yr) <u>Aug 30 94</u> under the business name of <u>Zinn Water Well Dng.</u> by (signature) <u>Joseph A. Zinn</u>
--

INSTRUCTIONS: Use typewriter or ball point pen. PLEASE PRESS FIRMLY and PRINT clearly. Please fill in blanks, underline or circle the correct answers. Send top three copies to Kansas Department of Health and Environment, Bureau of Water, Topeka, Kansas 66620-0001. Telephone: 913-296-5545. Send one to WATER WELL OWNER and retain one for your records.