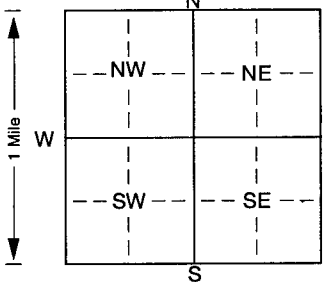


1 LOCATION OF WATER WELL: Fraction <u>SW 1/4 NW 1/4 NE 1/4</u> Section Number <u>29</u> Township Number <u>T 16 S</u> Range Number <u>R 9 E</u>	
County: <u>MOORE</u> Distance and direction from nearest town or city street address of well if located within city? <u>2.5 MILES EAST AND 2 MILES SOUTH OF COUNCIL GROVE</u>	
2 WATER WELL OWNER: <u>CHARLIE LAUGHRIDGE</u> RR#, St. Address, Box # : <u>Box 1</u> City, State, ZIP Code : <u>BEAVIDERE, MS. 67028</u> Board of Agriculture, Division of Water Resources Application Number: _____	
3 LOCATE WELL'S LOCATION WITH AN "X" IN SECTION BOX: 	4 DEPTH OF COMPLETED WELL: <u>105</u> ft. ELEVATION: _____ Depth(s) Groundwater Encountered <u>1 20</u> ft. 2. _____ ft. 3. _____ ft. WELL'S STATIC WATER LEVEL <u>18</u> ft. below land surface measured on mo/day/yr <u>5/12/00</u> Pump test data: Well water was _____ ft. after _____ hours pumping _____ gpm Est. Yield <u>1.5</u> gpm: Well water was _____ ft. after _____ hours pumping _____ gpm Bore Hole Diameter <u>8.75</u> in. to <u>105</u> ft., and _____ in. to _____ ft. WELL WATER TO BE USED AS: 5 Public water supply 8 Air conditioning 11 Injection well <u>1 Domestic</u> 3 Feedlot 6 Oil field water supply 9 Dewatering 12 Other (Specify below) 2 Irrigation 4 Industrial 7 Domestic (lawn & garden) 10 Monitoring well _____ Was a chemical/bacteriological sample submitted to Department? Yes. _____ No <u>X</u> ; If yes, mo/day/yr sample was submitted Water Well Disinfected? Yes <u>X</u> No _____
5 TYPE OF BLANK CASING USED: 1 Steel 3 RMP (SR) 5 Wrought iron 8 Concrete tile CASING JOINTS: Glued <u>X</u> Clamped _____ <u>2 PVC</u> 4 ABS 7 Fiberglass _____ Welded _____ Blank casing diameter <u>5</u> in. to <u>15</u> ft., Dia <u>5</u> in. to <u>105</u> ft., Dia _____ in. to _____ ft. Casing height above land surface <u>18</u> in., weight _____ lbs./ft. Wall thickness or gauge No. <u>SAR 26</u> TYPE OF SCREEN OR PERFORATION MATERIAL: 1 Steel 3 Stainless steel 5 Fiberglass <u>7 PVC</u> 10 Asbestos-cement 2 Brass 4 Galvanized steel 6 Concrete tile 8 RMP (SR) 11 Other (specify) _____ 2 None used (open hole) SCREEN OR PERFORATION OPENINGS ARE: 1 Continuous slot <u>3 Mill slot</u> 5 Gauzed wrapped 8 Saw cut 11 None (open hole) 2 Louvered shutter 4 Key punched 6 Wire wrapped 9 Drilled holes 7 Torch cut 10 Other (specify) _____ ft. SCREEN-PERFORATED INTERVALS: From <u>85</u> ft. to <u>105</u> ft., From _____ ft. to _____ ft. From <u>15</u> ft. to <u>25</u> ft., From _____ ft. to _____ ft. GRAVEL PACK INTERVALS: From <u>15</u> ft. to <u>105</u> ft., From _____ ft. to _____ ft. From _____ ft. to _____ ft., From _____ ft. to _____ ft.	
6 GROUT MATERIAL: 1 Neat cement 2 Cement grout <u>3 Bentonite</u> 4 Other _____ Grout Intervals: From <u>0</u> ft. to <u>15</u> ft., From _____ ft. to _____ ft., From _____ ft. to _____ ft. What is the nearest source of possible contamination: 1 Septic tank 4 Lateral lines 7 Pit privy 10 Livestock pens 14 Abandoned water well 2 Sewer lines 5 Cess pool 8 Sewage lagoon 11 Fuel storage 15 Oil well/Gas well 3 Watertight sewer lines 6 Seepage pit 9 Feedyard 12 Fertilizer storage 16 Other (specify below) Direction from well? _____ How many feet? <u>NEADLE OF PASTURES</u> <u>NO SOURCES CLOSE</u>	
FROM TO LITHOLOGIC LOG	FROM TO PLUGGING INTERVALS
0 5 SOIL	105 TOTAL DEPTH
5 8 SHALE, BROWN	
8 10 LIMESTONE	
10 19 SHALE, GRAY	
19 23 LIMESTONE, YELLOW	
23 31 SHALE, GRAY	
31 34 LIMESTONE, GRAY	
34 47 SHALE, LIGHT GRAY	
47 48 LIMESTONE	
48 77 SHALE, LIGHT GRAY	
77 82 LIMESTONE, TAN	
82 85 SHALE, LIGHT GRAY	
100 102 LIMESTONE	
102 105 SHALE, GRAY	
7 CONTRACTOR'S OR LANDOWNER'S CERTIFICATION: This water well was <u>(1)</u> constructed, (2) reconstructed, or (3) plugged under my jurisdiction and was completed on (mo/day/year) <u>5/12/00</u> and this record is true to the best of my knowledge and belief. Kansas Water Well Contractor's Licence No. <u>585</u> This Water Well Record was completed on (mo/day/yr) <u>6/1/00</u> under the business name of <u>ASSOC. ENVIRONMENTAL, INC.</u> by (signature) <u>[Signature]</u>	