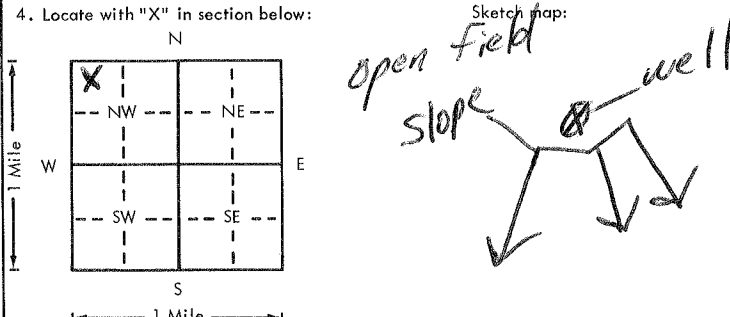


USE TYPEWRITER OR BALL  
POINT PEN-PRESS FIRMLY,  
PRINT CLEARLY.

WATER WELL RECORD  
KSA 82a-1201-1215

Kansas Department of Health and  
Environment-Division of Environment  
(Water well Contractors)  
Topeka, Kansas 66620

1. Location of well:	County <u>Lyon</u>	Fraction <u>NW 1/4 NW 1/4 NW 1/4</u>	Section number <u>2</u>	Township number <u>T 17 S</u>	Range number <u>R 11 E</u>	
2. Distance and direction from nearest town or city: <u>3 south 1/4 East</u> Street address of well location if in city: <u>Allen, Kansas</u>			3. Owner of well: <u>J.T. Kannady</u> R.R. or street: <u>Box 58</u> City, state, zip code: <u>Americus, Ks 66835</u>	
4. Locate with "X" in section below: 			6. Bore hole dia. <u>6</u> in. Completion date <u>10-29-79</u> Well depth <u>100'</u> ft.	
5. Type and color of material			7. <input checked="" type="checkbox"/> Cable tool <input type="checkbox"/> Rotary <input type="checkbox"/> Driven <input type="checkbox"/> Dug <input type="checkbox"/> Hollow rod <input type="checkbox"/> Jetted <input type="checkbox"/> Bored <input type="checkbox"/> Reverse rotary	
			8. Use: <input checked="" type="checkbox"/> Domestic <input type="checkbox"/> Public supply <input type="checkbox"/> Industry <input type="checkbox"/> Irrigation <input type="checkbox"/> Air conditioning <input type="checkbox"/> Stock <input type="checkbox"/> Lawn <input type="checkbox"/> Oil field water <input type="checkbox"/> Other	
			9. Casing: Material <u>styc</u> Height <u>Above</u> or below Threaded <input type="checkbox"/> Welded <u>che</u> Surface <u>2-4</u> in. RMP <input type="checkbox"/> PVC <input type="checkbox"/> Weight <input type="checkbox"/> lbs./ft. Dia. <u>5</u> in. to <u>100</u> ft. depth Wall Thickness: inches or Dia. <input type="checkbox"/> in. to <input type="checkbox"/> ft. depth gage No. <u>200</u>	
			10. Screen: Manufacturer's name <u>Jess + Lowell</u> Type <u>slit</u> Dia. <u>5-11</u> Slot/gauze <u>1/16</u> Length <u>20'</u> Set between <u>30'</u> ft. and <u>40'</u> ft. <u>80</u> ft. and <u>90</u> ft. Gravel pack? <u>no</u> Size range of material <u>        </u>	
<table border="1"><thead><tr><th></th><th>From</th><th>To</th></tr></thead><tbody><tr><td>Topsoil</td><td>Black</td><td>0 3</td></tr><tr><td>Clay</td><td>Tan</td><td>3 6</td></tr><tr><td>Shale</td><td>Yellow</td><td>6 26</td></tr><tr><td>Shale</td><td>Gray</td><td>26 32</td></tr><tr><td>Limestone - soft</td><td>1/2 Gray</td><td>32 34</td></tr><tr><td>Shale</td><td>Red</td><td>34 39</td></tr><tr><td>Shale</td><td>Gray</td><td>39 50</td></tr><tr><td>Limestone</td><td>1/2 Gray</td><td>50 52</td></tr><tr><td>Shale</td><td>Gray</td><td>52 63</td></tr><tr><td>Shale Hard</td><td>1/2 Gray</td><td>63 78</td></tr><tr><td>Limestone</td><td></td><td>78 80</td></tr><tr><td>Shale Hard</td><td>Gray</td><td>80 89</td></tr><tr><td>Limestone</td><td>1/2 Gray</td><td>89 92</td></tr><tr><td>Shale</td><td>1/2 Gray</td><td>92 100</td></tr>Static water level: <u>15</u> ft. below land surface Date <u>10-29-79</u> mo./day/yr.		
12. Pumping level below land surfaces: <u>        </u> ft. after <u>        </u> hrs. pumping <u>        </u> g.p.m. <u>        </u> ft. after <u>        </u> hrs. pumping <u>        </u> g.p.m. Estimated maximum yield <u>        </u> g.p.m.	
13. Water sample submitted: <u>        </u> mo./day/yr. Yes <input checked="" type="checkbox"/> No <input type="checkbox"/> Date <u>        </u>	
14. Well head completion: <u>        </u> <input checked="" type="checkbox"/> Pitless adapter <u>24</u> Inches above grade	
15. Well grouted? <input checked="" type="checkbox"/> With: <input checked="" type="checkbox"/> Neat cement <input type="checkbox"/> Bentonite <input type="checkbox"/> Concrete Depth: From <u>14</u> ft. to <u>4</u> ft.	
16. Nearest source of possible contamination: fr. <u>        </u> Direction <u>North</u> Type <u>Cattle</u> Well disinfected upon completion? <input checked="" type="checkbox"/> Yes <input type="checkbox"/> No	
17. Pump: <input checked="" type="checkbox"/> Not installed Manufacturer's name <u>        </u> Model number <u>        </u> HP <u>        </u> Volts <u>        </u> Length of drop pipe <u>        </u> ft. capacity <u>        </u> g.p.m. Type: <input type="checkbox"/> Submersible <input type="checkbox"/> Turbine <input type="checkbox"/> Jet <input type="checkbox"/> Reciprocating <input type="checkbox"/> Centrifugal <input type="checkbox"/> Other	
20. Water well contractor's certification: This well was drilled under my jurisdiction and this report is true to the best of my knowledge and belief. <u>Bledsoe Drilling Co. 349</u> Business name <u>        </u> License No. <u>        </u> Address <u>RR 1 Cottonwood Falls</u> Signed <u>John A. Bledsoe</u> Date <u>10-29-79</u> Authorized representative	
18. Elevation:	19. Remarks:	
Topography: <input checked="" type="checkbox"/> Hill <input type="checkbox"/> Slope <input type="checkbox"/> Upland <input type="checkbox"/> Valley	

Forward the white, blue and pink copies to the Department of Health and Environment

Form WWC-5