

CORRECTION(S) TO WATER WELL RECORD (WWC-5)

(to rectify lacking or incorrect information)

County: Osage

Location listed as:

Section-Township-Range: 27-175-19E

Fraction ($\frac{1}{4}$ $\frac{1}{4}$ $\frac{1}{4}$): SW SW NW

Location changed to:

27-175-16E

SW SW NW

Other changes: Initial statements: _____

Changed to: _____

Comments: _____

verification method: Written & legal descriptions, position on plat map, and county ownership map.


initials: DRJ date: 6/28/2005

1 LOCATION OF WATER WELL: County: O. Sage Fraction: SW 1/4 SW 1/4 NW 1/4 Section Number: 27 Township Number: T 17 S Range Number: R 19 E

Distance and direction from nearest town or city street address of well if located within city?
2 1/2 North Melvern Moors.

2 WATER WELL OWNER: Mrs Jones
 RR#, St. Address, Box #: RR
 City, State, ZIP Code: Melvorn Kans.
 Board of Agriculture, Division of Water Resources
 Application Number:

3 LOCATE WELL'S LOCATION WITH AN "X" IN SECTION BOX:

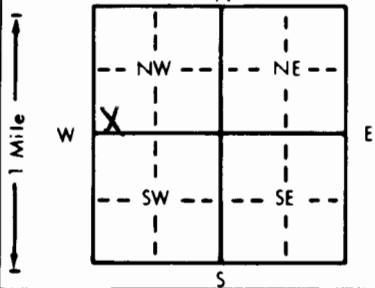

4 DEPTH OF COMPLETED WELL: 210 ft. ELEVATION: _____
 Depth(s) Groundwater Encountered 1. 190 ft. 2. _____ ft. 3. _____ ft.
 WELL'S STATIC WATER LEVEL: 150 ft. below land surface measured on mo/day/yr 10-18-90
 Pump test data: Well water was _____ ft. after _____ hours pumping _____ gpm
 Est. Yield 20+ gpm: Well water was _____ ft. after _____ hours pumping _____ gpm
 Bore Hole Diameter: 9 in. to 20 ft., and 6 3/8 in. to 210 ft.
 WELL WATER TO BE USED AS:
 Domestic Feedlot Oil field water supply Dewatering Injection well
 Irrigation Industrial Lawn and garden only Monitoring well
 Was a chemical/bacteriological sample submitted to Department? Yes _____ No If yes, mo/day/yr sample was submitted _____
 Water Well Disinfected? Yes No _____

5 TYPE OF BLANK CASING USED:
 1 Steel 3 RMP (SR) 5 Wrought iron 8 Concrete tile CASING JOINTS: Glued Clamped _____
 PVC 4 ABS 6 Asbestos-Cement 9 Other (specify below) Welded _____
 Fiberglass Threaded _____

Blank casing diameter: 4 1/2 in. to 190 ft., Dia _____ in. to _____ ft., Dia _____ in. to _____ ft.
 Casing height above land surface: 24 in., weight Sch 40 lbs./ft. Wall thickness or gauge No. Sch 40

TYPE OF SCREEN OR PERFORATION MATERIAL:
 1 Steel 3 Stainless steel 5 Fiberglass 8 RMP (SR) 10 Asbestos-cement
 2 Brass 4 Galvanized steel 6 Concrete tile 9 ABS 11 Other (specify) _____
 12 None used (open hole)

SCREEN OR PERFORATION OPENINGS ARE:
 1 Continuous slot 3 Mill slot 5 Gauzed wrapped 8 Saw cut 11 None (open hole)
 2 Louvered shutter 4 Key punched 6 Wire wrapped 9 Drilled holes
 7 Torch cut 10 Other (specify) _____

SCREEN-PERFORATED INTERVALS: From 190 ft. to 210 ft., From _____ ft. to _____ ft.
 From _____ ft. to _____ ft., From _____ ft. to _____ ft.
 GRAVEL PACK INTERVALS: From _____ ft. to _____ ft., From _____ ft. to _____ ft.
 From _____ ft. to _____ ft., From _____ ft. to _____ ft.

6 GROUT MATERIAL: 1 Neat cement 2 Cement grout 3 Bentonite 4 Other _____
 Grout Intervals: From 3 ft. to 20 ft., From _____ ft. to _____ ft., From _____ ft. to _____ ft.

What is the nearest source of possible contamination:
 1 Septic tank 4 Lateral lines 7 Pit privy 10 Livestock pens 14 Abandoned water well
 2 Sewer lines 5 Cess pool 8 Sewage lagoon 11 Fuel storage 15 Oil well/Gas well
 3 Watertight sewer lines 6 Seepage pit 9 Feedyard 12 Fertilizer storage 16 Other (specify below) _____
 13 Insecticide storage _____

Direction from well? West How many feet? 100

FROM	TO	LITHOLOGIC LOG	FROM	TO	PLUGGING INTERVALS
0	5	Soil & shell rock			
5	10	Clay			
10	12	grey shale			
12	25	grey shale			
25	35	lime sandstone shale			
35	76	grey sand shale			
76	86	lime shale			
86	92	lime shale			
92	117	lime shale			
117	120	Black shale			
120	132	lime shale			
132	154	lime shale			
154	160	lime shale			
160	190	lime shale			
190	210	grey sand			

7 CONTRACTOR'S OR LANDOWNER'S CERTIFICATION: This water well was constructed, (2) reconstructed, or (3) plugged under my jurisdiction and was completed on (mo/day/year) 10-18-90 and this record is true to the best of my knowledge and belief. Kansas Water Well Contractor's License No. W 86 This Water Well Record was completed on (mo/day/yr) 11-20-90 under the business name of Edgar Swank well Drilling by (signature) Edgar Swank