

USE TYPEWRITER OR BALL POINT PEN-PRESS FIRMLY, PRINT CLEARLY.


WATER WELL RECORD
KSA 82a-1201-1215

Kansas Department of Health and Environment-Division of Environment
(Water well Contractors)
Topeka, Kansas 66620

1. Location of well: County **Osage** Section number **25** Township number **17** Range number **16 E**

2. Distance and direction from nearest town or city: **2 1/2 miles NE 1/4**
Street address of well location if in city: **Melern**

3. Owner of well: **Bob Zabel**
R.R. or street: **RR1**
City, state, zip code: **Melern, Kan.**

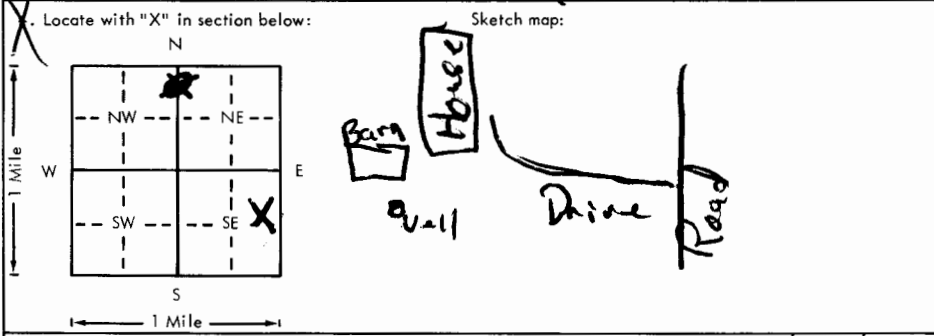

6. Bore hole dia. **6 1/2** in. Completion date **4-24-79**
Well depth **115** ft. **9" to 20"**

7. Cable tool Rotary Driven Dug
 Hollow rod Jetted Bored Reverse rotary

8. Use: Domestic Public supply Industry
 Irrigation Air conditioning Stock
 Lawn Oil field water Other

9. Casing: Material Height: Above or below
Threaded Welded Surface **18** in.
RMP PVC Weight **sch 40** lbs./ft.
Dia. **5 1/2** in. to **115** ft. depth Wall Thickness: inches or
Dia. in. to ft. depth gage No. **sch 40**

5. Type and color of material	From	To
soil	0	3
gravel	3	6
clay	6	18
lime	18	23
shald	23	80
grey sand	80	115

10. Screen: Manufacturer's name **Crown Line**

Type **PVC** Dia. **5 1/2**
Slot/gauze **3/8** Length **20**
Set between **95** ft. and **115** ft.
Gravel pack? **no** Size range of material

11. Static water level: **40** ft. below land surface Date **4-24-79**

12. Pumping level below land surfaces:
ft. after ___ hrs. pumping ___ g.p.m.
ft. after ___ hrs. pumping **4** g.p.m.
Estimated maximum yield ___ g.p.m.

13. Water sample submitted: ___ mo./day/yr.
Yes No Date

14. Well head completion: **Pump House**
 Pitless adapter ___ inches above grade

15. Well grouted? ___
With: Neat cement Bentonite Concrete
Depth: From **0** ft. to **20** ft.

16. Nearest source of possible contamination:
ft. **100** Direction **NE** type **septic**
Well disinfected upon completion? Yes ___ No

17. Pump: Not installed
Manufacturer's name **Red Jacket**
Model number **50F19BC** HP **1 1/2** Volts **220**
Length of drop pipe ___ ft. capacity ___ g.p.m.
Type:
 Submersible ___ Turbine
___ Jet ___ Reciprocating
___ Centrifugal ___ Other

18. Elevation: Topography: Hill ___ Slope ___ Upland ___ Valley

19. Remarks:

20. Water well contractor's certification:
This well was drilled under my jurisdiction and this report is true to the best of my knowledge and belief.
Royce Swank Drilling 371
Business name License No.
Address **RR1, Ottawa, Kansas**
Signed **Royce Swank** Date **5-20**
Authorized representative

17 160 25 SE 1/4