


USE TYPEWRITER OR BALL POINT PEN-PRESS FIRMLY, PRINT CLEARLY.

WATER WELL RECORD
KSA 82a-1201-1215

Kansas Department of Health and Environment-Division of Environment
(Water well Contractors)
Topeka, Kansas 66620

1. Location of well: County **Osage** Fraction **NW 1/4 NW 1/4 NE 1/4** Section number **35** Township number **T 17 S R 16** Range number **E 4**

2. Distance and direction from nearest town or city: **2 N 1 1/2 E**
Street address of well location if in city: **Melvern**
3. Owner of well: **Melvin Lindstrom**
R.R. or street: **RR1**
City, state, zip code: **Melvern, Kansas**

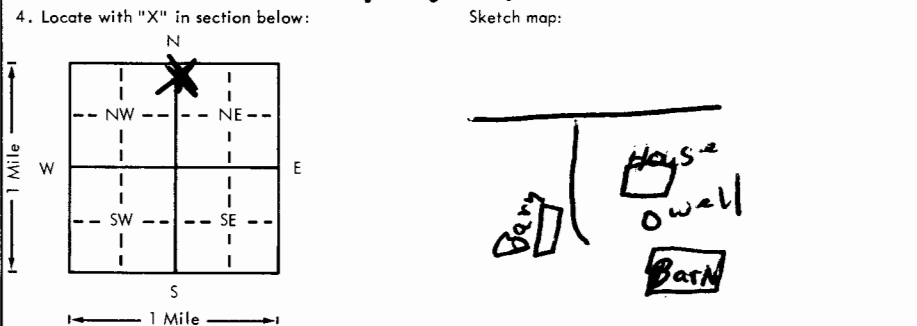

6. Bore hole dia. **6 1/2** in. Completion date **3-30-79**
Well depth **155** ft. **9-10-20**
7. Cable tool Rotary Driven Dug
 Hollow rod Jetted Bored Reverse rotary
8. Use: Domestic Public supply Industry
 Irrigation Air conditioning Stock
 Lawn Oil field water Other
9. Casing: Material _____ Height: Above or below _____
Threaded _____ Welded _____ Surface **18** in.
RMP _____ PVC Weight **sch 40** lbs./ft.
Dia. **5 1/2** in. to **155** ft. depth Wall thickness: inches or
Dia. **6 1/4** in. to **20** ft. depth Gage No. **sch 40**

5. Type and color of material	From	To
soil soil	0	4
gravel	4	7
clay	7	17
lime	17	25
shald	25	43
lime	43	59
Black shald	59	61
lime	61	63
light blue shald	63	73
lime	73	93
shald	93	98
lime	98	121
shald	121	140
white sand	140	153
lime	153	155

10. Screen: Manufacturer's name **Crown line**
Type **PVC** Dia. **5 1/2**"
Slot/gauze **3/8** Length **20**
Set between **135** ft. and **155** ft.
Gravel pack? Size range of material _____
11. Static water level: _____ mo./day/yr.
105 ft. below land surface Date **3-30-79**
12. Pumping level below land surfaces:
_____ ft. after _____ hrs. pumping _____ g.p.m.
_____ ft. after _____ hrs. pumping _____ g.p.m.
Estimated maximum yield **20** g.p.m.
13. Water sample submitted: _____ mo./day/yr.
Yes _____ No _____ Date _____
14. Well head completion:
 Pitless adapter _____ Inches above grade
15. Well grouted? _____
With: Neat cement _____ Bentonite _____ Concrete _____
Depth: From **3** ft. to **20** ft.
16. Nearest source of possible contamination:
ft. **75** Direction **north** Type **septic**
Well disinfected upon completion? Yes _____ No _____
17. Pump: Not installed
Manufacturer's name _____
Model number _____ HP _____ Volts _____
Length of drop pipe _____ ft. capacity _____ g.p.m.
Type:
 Submersible Turbine
 Jet Reciprocating
 Centrifugal Other

18. Elevation: _____
19. Remarks: _____
Topography:
 Hill
 Slope
 Upland
 Valley

20. Water well contractor's certification:
This well was drilled under my jurisdiction and this report is true to the best of my knowledge and belief.
Royce Swank Drilling 371
Business name License No. _____
Address **RR1 Ottawa Kansas 66067**
Signed **Royce Swank** Date **5-20-79**
Authorized representative

177 160 35 AUG 6 1979