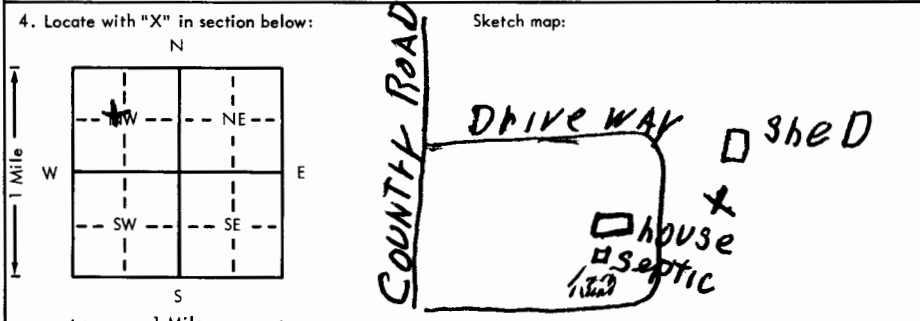


USE TYPEWRITER OR BALL
POINT PEN-PRESS FIRMLY,
PRINT CLEARLY.

WATER WELL RECORD
KSA 82a-1201-1215

Kansas Department of Health and
Environment-Division of Environment
(Water well Contractors)
Topeka, Kansas 66620

1. Location of well:	County Franklin	Fraction NE 1/4 NE 1/4 NW 1/4	Section number 23	Township number T 17 S R 17 E/W	Range number
2. Distance and direction from nearest town or city: Street address of well location if in city:			3. Owner of well: Anton Earl Rasmussen R.R. or street: RR City, state, zip code: Queamo Kansas		
4. Locate with "X" in section below: 			6. Bore hole dia. 6 1/2 in. Completion date 7-4-77 Well depth 207 ft.		
5. Type and color of material			7. <input checked="" type="checkbox"/> Cable tool <input type="checkbox"/> Rotary <input type="checkbox"/> Driven <input type="checkbox"/> Dug <input type="checkbox"/> Hollow rod <input type="checkbox"/> Jetted <input type="checkbox"/> Bored <input type="checkbox"/> Reverse rotary		
			8. Use: <input checked="" type="checkbox"/> Domestic <input type="checkbox"/> Public supply <input type="checkbox"/> Industry <input type="checkbox"/> Irrigation <input type="checkbox"/> Air conditioning <input type="checkbox"/> Stock <input type="checkbox"/> Lawn <input type="checkbox"/> Oil field water <input type="checkbox"/> Other		
			9. Casing: Material <input type="checkbox"/> Height: Above or below ground Threaded <input type="checkbox"/> Welded <input type="checkbox"/> Surface 18 in. RMP <input type="checkbox"/> PVC <input checked="" type="checkbox"/> Weight sch 40 /ft. Dia. 5 in. to 207 ft. depth Wall Thickness: inches or Dia. <input type="checkbox"/> in. to <input type="checkbox"/> ft. depth gage No. sch 40		
			10. Screen: Manufacturer's name crown line Type pvc Dia. 5 Slot/gauze 1/8 Length 60 Set between 187 ft. and 207 ft. Gravel pack? no Size range of material		
			11. Static water level: <input type="checkbox"/> mo./day/yr. 97 ft. below land surface Date 7-4-77		
			12. Pumping level below land surfaces: ft. after <input type="checkbox"/> hrs. pumping <input type="checkbox"/> g.p.m. ft. after <input type="checkbox"/> hrs. pumping <input type="checkbox"/> g.p.m. Estimated maximum yield 6 g.p.m.		
			13. Water sample submitted: <input type="checkbox"/> mo./day/yr. Yes <input checked="" type="checkbox"/> No Date		
			14. Well head completion: pump house Pitless adapter <input type="checkbox"/> inches above grade		
			15. Well grouted? yes With: <input checked="" type="checkbox"/> Neat cement <input type="checkbox"/> Bentonite <input type="checkbox"/> Concrete Depth: From 0 ft. to 18 ft.		
			16. Nearest source of possible contamination: ft. 100 Direction SW Type septic Well disinfected upon completion? <input type="checkbox"/> Yes <input type="checkbox"/> No		
			17. Pump: <input checked="" type="checkbox"/> Not installed Manufacturer's name Model number <input type="checkbox"/> HP <input type="checkbox"/> Volts <input type="checkbox"/> Length of drop pipe <input type="checkbox"/> ft. capacity <input type="checkbox"/> g.p.m. Type: <input type="checkbox"/> Submersible <input type="checkbox"/> Turbine <input type="checkbox"/> Jet <input type="checkbox"/> Reciprocating <input type="checkbox"/> Centrifugal <input type="checkbox"/> Other		
			(Use a second sheet if needed)		
18. Elevation:	19. Remarks:		20. Water well contractor's certification:		
Topography: <input type="checkbox"/> Hill <input checked="" type="checkbox"/> Slope <input type="checkbox"/> Upland <input type="checkbox"/> Valley	coustom put pump in and put cement platform		This well was drilled under my jurisdiction and this report is true to the best of my knowledge and belief. EDGAR SWANK 124A Business name License No. Address RR 4 OTTAWA KANS. Signed Edgar Swank Date 8-4-77 Authorized representative		