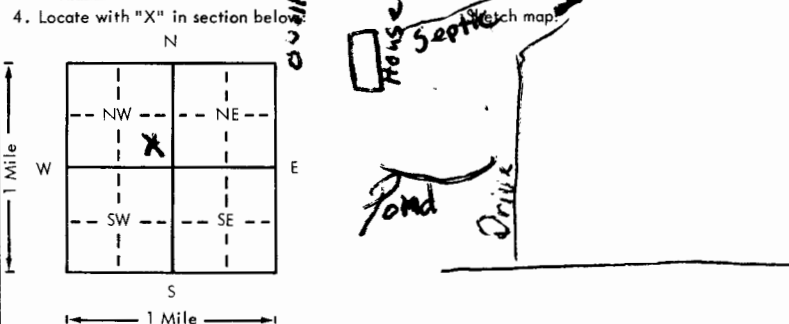


USE TYPEWRITER OR BALL
POINT PEN-PRESS FIRMLY,
PRINT CLEARLY.

WATER WELL RECORD
KSA 82a-1201-1215

Kansas Department of Health and
Environment-Division of Environment
(Water well Contractors)
Topeka, Kansas 66620

1. Location of well:	County Franklin	Fraction SE 1/4 SE 1/4 NW 1/4	Section number 24	Township number T 17	Range number S R 17	E/W
2. Distance and direction from nearest town or city: 1 1/2 N 90 W 1/2		3. Owner of well: CD Weamer R.R. or street: City, state, zip code: Williamburg, Kan 66799				
4. Locate with "X" in section below: 		6. Bore hole dia. 6 1/2 in. Completion date 9/19/79 Well depth 150 ft. 9" to 20"				
5. Type and color of material		From	To	7. <input checked="" type="checkbox"/> Cable tool <input type="checkbox"/> Rotary <input type="checkbox"/> Driven <input type="checkbox"/> Dig <input type="checkbox"/> Hollow rod <input type="checkbox"/> Jetted <input type="checkbox"/> Bored <input type="checkbox"/> Reverse rotary		
selly Rock		0	6	8. Use: <input checked="" type="checkbox"/> Domestic <input type="checkbox"/> Public supply <input type="checkbox"/> Industry <input type="checkbox"/> Irrigation <input type="checkbox"/> Air conditioning <input type="checkbox"/> Stock <input type="checkbox"/> Lawn <input type="checkbox"/> Oil field water <input type="checkbox"/> Other		
clay		6	10	9. Casing: Material <input type="checkbox"/> Height: Above or below Threaded <input type="checkbox"/> Welded <input type="checkbox"/> Surface 18 in. RMP <input type="checkbox"/> PVC <input checked="" type="checkbox"/> Weight sch 40 lbs./ft. Dia. 5 in. to 150 ft. depth Wall Thickness: inches or Dia. 6 1/2 in. to 20 ft. depth gage No. sch 40		
shald		10	20	10. Screen: Manufacturer's name crow line Type PVC Dia. 5 Slot/gauze 3/8 Length 20 Set between 130 ft. and 150 ft. _____ ft. and _____ ft. Gravel pack? no Size range of material _____		
lime		20	25	11. Static water level: _____ mo./day/yr. 80 ft. below land surface Date _____		
shald		25	75	12. Pumping level below land surfaces: _____ ft. after _____ hrs. pumping _____ g.p.m. _____ ft. after _____ hrs. pumping _____ g.p.m. Estimated maximum yield 6 g.p.m.		
lime		75	85	13. Water sample submitted: _____ mo./day/yr. Yes <input checked="" type="checkbox"/> No <input type="checkbox"/> Date _____		
grey sanded shald		85	125	14. Well head completion: <input checked="" type="checkbox"/> Pitless adapter _____ Inches above grade		
white sand		125	150	15. Well grouted? _____ With <input checked="" type="checkbox"/> Neat cement _____ Bentonite _____ Concrete _____ Depth: From 3 ft. to 20 ft.		
				16. Nearest source of possible contamination: ft. 100 Direction north Type septic Well disinfected upon completion? _____ Yes _____ No		
				17. Pump: <input checked="" type="checkbox"/> Not installed Manufacturer's name _____ Model number _____ HP _____ Volts _____ Length of drop pipe _____ ft. capacity _____ g.p.m. Type: ____ Submersible _____ Turbine ____ Jet _____ Reciprocating ____ Centrifugal _____ Other _____		
18. Elevation:		19. Remarks:		20. Water well contractor's certification: This well was drilled under my jurisdiction and this report is true to the best of my knowledge and belief. Royce Swank Drilling 371 Business name _____ License No. _____ Address 3824 Ottawa, Kan. 66067 Signed Royce Swank Date 3/20/80 Authorized representative		