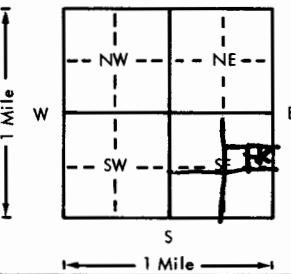
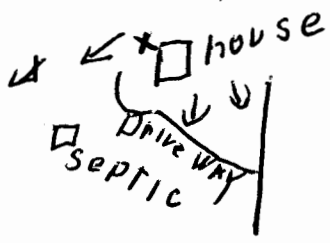


USE TYPEWRITER OR BALL
POINT PEN-PRESS FIRMLY,
PRINT CLEARLY.

WATER WELL RECORD
KSA 82a-1201-1215

Kansas Department of Health and
Environment-Division of Environment
(Water well Contractors)
Topeka, Kansas 66620

1. Location of well:		County FRANKLIN	Fraction SE 1/4 NE 1/4 SE 1/4	Section number 526	Township number T 17 S	Range number R 17 E
Distance and direction from nearest town or city: 1 E. - 35 - Queenemo				3. Owner of well: BILL PRIDDY R.R. or street: City, state, zip code: QUEENEMO KANSAS		
4. Locate with "X" in section below:		Sketch map:				
						
5. Type and color of material		From	To	6. Bore hole dia. 6 1/4 in. Completion date 5-6-76 Well depth 180 ft. 20' 8 1/4		
soil		0	15	7. Cable tool <input type="checkbox"/> Rotary <input type="checkbox"/> Driven <input type="checkbox"/> Dug <input type="checkbox"/> <input type="checkbox"/> Hollow rod <input type="checkbox"/> Jetted <input type="checkbox"/> Bored <input type="checkbox"/> Reverse rotary		
lime		15	27	8. Use: <input checked="" type="checkbox"/> Domestic <input type="checkbox"/> Public supply <input type="checkbox"/> Industry <input type="checkbox"/> <input type="checkbox"/> Irrigation <input type="checkbox"/> Air conditioning <input type="checkbox"/> Stock <input type="checkbox"/> <input type="checkbox"/> Lawn <input type="checkbox"/> Oil field water <input type="checkbox"/> Other		
black shale		27	32	9. Casing: Material STAINLESS Height: Above or below Threaded <input type="checkbox"/> Welded <input type="checkbox"/> Surface PUMP HOUSE RMP <input type="checkbox"/> PVC <input type="checkbox"/> Weight <input type="checkbox"/> lbs./ft. Dia. 5 in. to 180 ft. depth Wall Thickness: inches or Dia. <input type="checkbox"/> in. to <input type="checkbox"/> ft. depth gage No. 320		
				10. Screen: Manufacturer's name SCREEN CUT WITH SAW Type <input type="checkbox"/> Dia. 5 Slot/gauze <input type="checkbox"/> Length 20 Set between 160 ft. and 180 ft. <input type="checkbox"/> ft. and <input type="checkbox"/> ft. Gravel pack? <input type="checkbox"/> Size range of material <input type="checkbox"/>		
				11. Static water level: 100 ft. below land surface Date 5-8-76 mo./day/yr.		
				12. Pumping level below land surfaces: <input type="checkbox"/> ft. after <input type="checkbox"/> hrs. pumping <input type="checkbox"/> g.p.m. <input type="checkbox"/> ft. after <input type="checkbox"/> hrs. pumping <input type="checkbox"/> g.p.m. Estimated maximum yield 12 g.p.m.		
				13. Water sample submitted: <input type="checkbox"/> mo./day/yr. Yes <input checked="" type="checkbox"/> No <input type="checkbox"/> Date		
				14. Well head completion: PUMP HOUSE <input type="checkbox"/> Pitless adapter <input type="checkbox"/> Inches above grade		
				15. Well grouted? <input checked="" type="checkbox"/> With: <input checked="" type="checkbox"/> Neat cement <input type="checkbox"/> Bentonite <input type="checkbox"/> Concrete Depth: From 0 ft. to 20 ft.		
				16. Nearest source of possible contamination: ft. 80 Direction W Type SEPTIC Well disinfected upon completion? <input checked="" type="checkbox"/> Yes <input type="checkbox"/> No		
				17. Pump: <input checked="" type="checkbox"/> Not installed Manufacturer's name RED JACKET Model number SON198 HP 1/2 Volts 230 Length of drop pipe 170 ft. capacity 10 g.p.m. Type: <input checked="" type="checkbox"/> Submersible <input type="checkbox"/> Turbine <input type="checkbox"/> Jet <input type="checkbox"/> Reciprocating <input type="checkbox"/> Centrifugal <input type="checkbox"/> Other		
18. Elevation:		19. Remarks:		20. Water well contractor's certification:		
Topography: <input checked="" type="checkbox"/> Hill <input checked="" type="checkbox"/> Slope <input type="checkbox"/> Upland <input type="checkbox"/> Valley		This was completed on 5-20-76		This well was drilled under my jurisdiction and this report is true to the best of my knowledge and belief. EDGAR SWANK 124 Business name RH OTTAWA KANSAS License No. Address Edgar Swank Date 6-6-76 Signed Edgar Swank Authorized representative		