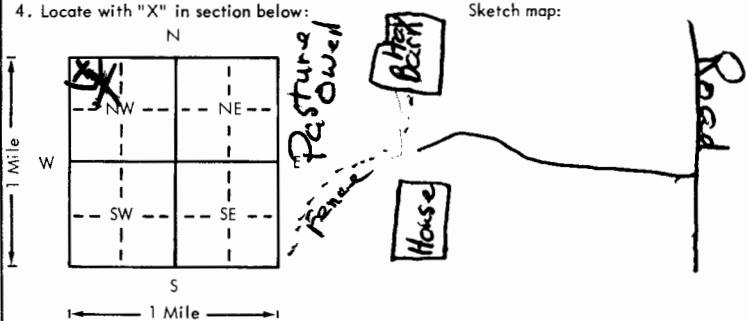


USE TYPEWRITER OR BALL  
POINT PEN-PRESS FIRMLY,  
PRINT CLEARLY.

WATER WELL RECORD  
KSA 82a-1201-1215

Kansas Department of Health and  
Environment-Division of Environment  
(Water well Contractors)  
Topeka, Kansas 66620

1. Location of well:		County <b>Franklin</b>	Fraction <b>NW 1/4 NW 1/4 NW 1/4</b>	Section number <b>26</b>	Township number <b>T 17</b>	Range number <b>S R 17</b>	<b>EW</b>
2. Distance and direction from nearest town or city: <b>East 2 1/2 miles</b> Street address of well location if in city: <b>Queenemo</b>				3. Owner of well: <b>Mark Dodge</b> R.R. or street: City, state, zip code: <b>Queenemo, Kan.</b>			
4. Locate with "X" in section below: 				6. Bore hole dia. <b>8 1/4</b> in. Completion date <b>11-28-78</b> Well depth <b>190</b> ft. <b>9" to 20</b>			
5. Type and color of material				7. <input checked="" type="checkbox"/> Cable tool <input type="checkbox"/> Rotary <input type="checkbox"/> Driven <input type="checkbox"/> Dug <input type="checkbox"/> Hollow rod <input type="checkbox"/> Jetted <input type="checkbox"/> Bored <input type="checkbox"/> Reverse rotary			
				8. Use: <input checked="" type="checkbox"/> Domestic <input type="checkbox"/> Public supply <input type="checkbox"/> Industry <input checked="" type="checkbox"/> Irrigation <input type="checkbox"/> Air conditioning <input type="checkbox"/> Stock <input type="checkbox"/> Lawn <input type="checkbox"/> Oil field water <input type="checkbox"/> Other			
				9. Casing: Material <input type="checkbox"/> Height: Above or below Threaded <input type="checkbox"/> Welded <input type="checkbox"/> Surface <b>18</b> in. RMP <input type="checkbox"/> PVC <input checked="" type="checkbox"/> Weigh <b>sch 40</b> lbs./ft. Dia. <b>6 1/2</b> in. to <b>20</b> ft. depth Wall thickness: inches or Dia. <b>5</b> in. to <b>190</b> ft. depth <b>sch 40</b>			
				10. Screen: Manufacturer's name <b>crown line</b> Type <b>PVC</b> Dia. <b>5</b> Slot/gauze <b>3/8</b> Length <b>30</b> Set between <b>160</b> ft. and <b>190</b> ft. Gravel pack? <b>no</b> Size range of material			
				11. Static water level: <b>90</b> ft. below land surface Date <b>11-28-78</b> mo./day/yr.			
				12. Pumping level below land surfaces: ft. after hrs. pumping g.p.m. ft. after hrs. pumping g.p.m. Estimated maximum yield <b>2 1/2</b> g.p.m.			
				13. Water sample submitted: <b>X</b> Yes <b>X</b> No Date			
				14. Well head completion: <b>capped.</b> Pitless adapter <b>18</b> inches above grade			
				15. Well grouted? <b>yes</b> With <input checked="" type="checkbox"/> Neat cement <input type="checkbox"/> Bentonite <input type="checkbox"/> Concrete Depth: From <b>0</b> ft. to <b>20</b> ft.			
				16. Nearest source of possible contamination: <b>BARN</b> ft. <b>50</b> Direction <b>West</b> Type <b>Lot</b> Well disinfected upon completion? <input checked="" type="checkbox"/> Yes <input type="checkbox"/> No			
				17. Pump: <input checked="" type="checkbox"/> Not installed Manufacturer's name Model number HP Volts Length of drop pipe ft. capacity g.p.m. Type: <input type="checkbox"/> Submersible <input type="checkbox"/> Turbine <input type="checkbox"/> Jet <input type="checkbox"/> Reciprocating <input type="checkbox"/> Centrifugal <input type="checkbox"/> Other			
18. Elevation:				19. Remarks: <b>Irrigate Fruit Trees</b>			
Topography: <input checked="" type="checkbox"/> Hill <input type="checkbox"/> Slope <input type="checkbox"/> Upland <input type="checkbox"/> Valley				20. Water well contractor's certification: This well was drilled under my jurisdiction and this report is true to the best of my knowledge and belief. <b>Royce Swank Drilling 371</b> Business name License No. Address <b>RR4 Ottawa, Kan.</b> Signed <b>Royce Swank</b> Date <b>3-9-79</b> Authorized representative			