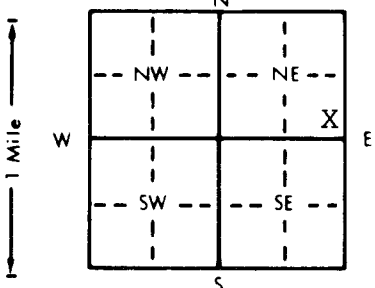


1 LOCATION OF WATER WELL:		Fraction	Section Number	Township Number	Range Number
County: <b>FRANKLIN</b>		<b>SE 1/4 SE 1/4 NE 1/4</b>	<b>35</b>	<b>T 17 S</b>	<b>R 17 E/W</b>
Distance and direction from nearest town or city street address of well if located within city? <b>1 west, 3 north of Williamsburg</b>					
2 WATER WELL OWNER: <b>Sam Bolei</b>					
RR#, St. Address, Box # : <b>2018 Arkansas Rd.</b>			Board of Agriculture, Division of Water Resources		
City, State, ZIP Code : <b>Quenemo, KS 66528</b>			Application Number:		
3 LOCATE WELL'S LOCATION WITH AN "X" IN SECTION BOX:		4 DEPTH OF COMPLETED WELL: <b>240'</b> ft. ELEVATION:			
<div style="text-align: center;"></div>		Depth(s) Groundwater Encountered 1. .... ft. 2. .... ft. 3. .... ft.			
		WELL'S STATIC WATER LEVEL <b>131'</b> ft. below land surface measured on mo/day/yr <b>6-24-94</b>			
		Pump test data: Well water was .... ft. after .... hours pumping .... gpm			
		Est. Yield <b>7</b> gpm: Well water was .... ft. after .... hours pumping .... gpm			
		Bore Hole Diameter: <b>8 3/4</b> in. to .... ft., and .... in. to .... ft.			
		WELL WATER TO BE USED AS:			
		5 Public water supply 8 Air conditioning 11 Injection well			
		1 Domestic 3 Feedlot 6 Oil field water supply 9 Dewatering 12 Other (Specify below)			
		2 Irrigation 4 Industrial 7 Lawn and garden only 10 Monitoring well			
		Was a chemical/bacteriological sample submitted to Department? Yes.....No..... <b>X</b> .....; If yes, mo/day/yr sample was submitted			
		Water Well Disinfected? Yes <b>X</b> No			
5 TYPE OF BLANK CASING USED:					
1 Steel		3 RMP (SR)	5 Wrought iron	8 Concrete tile	CASING JOINTS: Glued <b>X</b> Clamped
2 PVC		4 ABS	6 Asbestos-Cement	9 Other (specify below)	Welded
			7 Fiberglass		Threaded
Blank casing diameter .... <b>5"</b> in. to <b>0-140</b> ft., Dia .... <b>5"</b> in. to <b>200-240</b> ft., Dia .... in. to .... ft.					
Casing height above land surface .... <b>24"</b> in., weight .... <b>2.82</b> lbs./ft. Wall thickness or gauge No. .... <b>258</b>					
TYPE OF SCREEN OR PERFORATION MATERIAL:					
1 Steel		3 Stainless steel	5 Fiberglass	7 PVC	10 Asbestos-cement
2 Brass		4 Galvanized steel	6 Concrete tile	8 RMP (SR)	11 Other (specify) .....
				9 ABS	12 None used (open hole)
SCREEN OR PERFORATION OPENINGS ARE:					
1 Continuous slot		3 Mill slot	5 Gauzed wrapped	8 Saw cut	11 None (open hole)
2 Louvered shutter		4 Key punched	6 Wire wrapped	9 Drilled holes	
			7 Torch cut	10 Other (specify) .....	
SCREEN-PERFORATED INTERVALS: From .... <b>140</b> ft. to .... <b>200</b> ft., From .... ft. to .... ft.					
GRAVEL PACK INTERVALS: From .... <b>24</b> ft. to .... <b>240</b> ft., From .... ft. to .... ft.					
6 GROUT MATERIAL:					
1 Neat cement		2 Cement grout	3 Bentonite	4 Other	
Grout Intervals: From .... <b>4</b> ft. to .... <b>24</b> ft., From .... ft. to .... ft., From .... ft. to .... ft.					
What is the nearest source of possible contamination:					
1 Septic tank		4 Lateral lines	7 Pit privy	10 Livestock pens	14 Abandoned water well
2 Sewer lines		5 Cess pool	8 Sewage lagoon	11 Fuel storage	15 Oil well/Gas well
3 Watertight sewer lines		6 Seepage pit	9 Feedyard	12 Fertilizer storage	16 Other (specify below)
				13 Insecticide storage	
Direction from well? <b>east</b>		How many feet? <b>130'</b>			
FROM	TO	LITHOLOGIC LOG	FROM	TO	PLUGGING INTERVALS
0	5	Clay-Brown	130	179	Sandstone-Grey
5	19	Limestone-Tan	179	182	Shale-Grey
19	26	Shale-Grey	182	185	Shaley Limestone-Grey
26	27	Limestone-Grey	185	192	Sandstone-Grey
27	41	Shale-Grey	192	193	Limestone-Grey
41	70	Limestone-Tan	193	197	Sandstone-Grey
70	83	Shale-Black	197	205	Shale-Grey
83	89	Limestone-Grey	205	207	Limestone-Grey
89	91	Shale-Grey	207-225		Sandy Shale-Grey
91	92	Limestone-Grey	225	227	Limestone-Grey
92	96	Shale-Grey	227	240	Shale-Grey
96	97	Limestone-Grey			
97	110	Shale-Grey			
110	113	Sandstone-Grey			
113	130	Sandy Shale-Grey			
7 CONTRACTOR'S OR LANDOWNER'S CERTIFICATION: This water well was (1) constructed, (2) reconstructed, or (3) plugged under my jurisdiction and was completed on (mo/day/year) .... <b>6-24-94</b> and this record is true to the best of my knowledge and belief. Kansas Water Well Contractor's License No. .... <b>182</b> This Water Well Record was completed on (mo/day/yr) .... <b>7-19-94</b> under the business name of <b>STRADER DRILLING CO., INC.</b> by (signature) <i>Don H. Strader</i>					