

II 3


USE TYPEWRITER OR BALL POINT PEN-PRESS FIRMLY, PRINT CLEARLY.

WATER WELL RECORD
KSA 82a-1201-1215

Kansas Department of Health and Environment-Division of Environment
(Water well Contractors)
Topeka, Kansas 66620

1. Location of well:	County Osage	Fraction 1/4 SW 1/4 NW 1/4	Section number 7	Township number T 17 S	Range number R 17 E
----------------------	------------------------	--------------------------------------	----------------------------	----------------------------------	-------------------------------

2. Distance and direction from nearest town or city: 3 Mi WEST Street address of well location if in city: 9 LENOMO, KAN 1/4 Mi NORTH	3. Owner of well: Andy Duffie R.R. or street: RR City, state, zip code: Pomona, Kansas 66076
--	---

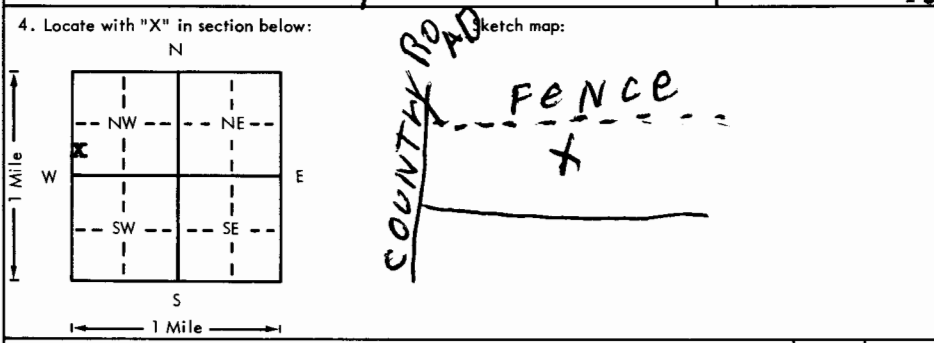

6. Bore hole dia. **5 1/4** in. Completion date **3-23-77**
Well depth **200** ft. **9" to 20"**

7. Cable tool Rotary Driven Dug
 Hollow rod Jetted Bored Reverse rotary

8. Use: Domestic Public supply Industry
 Irrigation Air conditioning Stock
 Lawn Oil field water Other

9. Casing: Material _____ Height: Above or below
Threaded _____ Welded _____ Surface **12** in.
RMP _____ PVC Weight **sch 40** /ft.
Dia. **5** in. to **200** ft. depth Wall Thickness: inches or
Dia. _____ in. to _____ ft. depth gage No. **sch 40**

5. Type and color of material	From	To
Soil	0	2
Shelly Lime	2	4
Grey Sanded Shale	4	25
Lime	25	83
Shale	83	96
shald Lime	36	43
shald	43	61
lime	61	79
Grey sand rock	79	110
sanded grey shald	110	170
grey sand	170	200

10. Screen: Manufacturer's name **crown line**
Type **PVC** Dia. **5**
Slot/gauze **3/4** Length **30**
Set between **170** ft. and **200** ft.
ft. and _____ ft.
Gravel pack? No Size range of material: _____

11. Static water level: _____ mo./day/yr.
100 ft. below land surface Date **1/14/77**

12. Pumping level below land surfaces:
100 ft. after _____ hrs. pumping _____ g.p.m.
_____ ft. after _____ hrs. pumping _____ g.p.m.
Estimated maximum yield **6** g.p.m.

13. Water sample submitted: _____ mo./day/yr.
 Yes No Date _____

14. Well head completion:
 Pitless adapter **pump house** above grade

15. Well grouted? **yes**
With: Neat cement Bentonite Concrete
Depth: From **0** ft. to **20** ft.

16. Nearest source of possible contamination _____
ft. _____ Direction _____ Type _____
Well disinfected upon completion? Yes No

17. Pump: _____ Not installed
Manufacturer's name **Red Jacket**
Model number **50N1988** HP **1/2** Volts **220**
Length of drop pipe **190** ft. capacity **10** g.p.m.
Type:
 Submersible Turbine
 Jet Reciprocating
 Centrifugal Other

18. Elevation:

19. Remarks:
ED **KNOW**
Drilling in a pasture no known contamination
This is a - A.S.C.S. STOCK WELL

Topography:
 Hill
 Slope
 Upland
 Valley

20. Water well contractor's certification:
This well was drilled under my jurisdiction and this report is true to the best of my knowledge and belief.
Edgar Swank **124A**
Business name License No.
Address **RR, Ottawa, Kan.**
Signed **Edgar Swank** Date **4-10-77**
Authorized representative

T
R
W
E
S
C
17 120 7 50NW