


1 LOCATION OF WATER WELL: Fraction *SE 1/4 SE 1/4 SW 1/4* Section Number *8* Township Number *T 17 S* Range Number *R 17 W*

County: *Osage* Distance and direction from nearest town or city street address of well if located within city? *2 west Guernsey*

2 WATER WELL OWNER: RR# , St. Address, Box # : *RR Guernsey Kans.* Board of Agriculture, Division of Water Resources
 City, State, ZIP Code : *Guernsey Kans.* Application Number:

3 LOCATE WELL'S LOCATION WITH AN "X" IN SECTION BOX: 4 DEPTH OF COMPLETED WELL: *225* ft. ELEVATION: _____

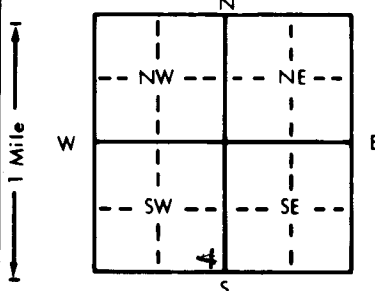

Depth(s) Groundwater Encountered 1. _____ ft. 2. _____ ft. 3. _____ ft.
 WELL'S STATIC WATER LEVEL _____ ft. below land surface measured on mo/day/yr *7-19-89*
 Pump test data: Well water was _____ ft. after _____ hours pumping _____ gpm
 Est. Yield *18+* gpm: Well water was _____ ft. after _____ hours pumping _____ gpm
 Bore Hole Diameter _____ in. to _____ ft., and _____ in. to _____ ft.
 WELL WATER TO BE USED AS: 5 Public water supply 8 Air conditioning 11 Injection well
 ① Domestic 3 Feedlot 6 Oil field water supply 9 Dewatering 12 Other (Specify below)
 2 Irrigation 4 Industrial 7 Lawn and garden only 10 Monitoring well *Pasture*
 Was a chemical/bacteriological sample submitted to Department? Yes _____ No If yes, mo/day/yr sample was submitted _____
 Water Well Disinfected? Yes No _____

5 TYPE OF BLANK CASING USED: 5 Wrought iron 8 Concrete tile CASING JOINTS: Glued Clamped _____
 ① Steel 3 RMP (SR) 6 Asbestos-Cement 9 Other (specify below) Welded _____
 4 ABS 7 Fiberglass *Styrene* Threaded _____

Blank casing diameter *6 1/4* in. to *7* ft., Dia *5* in. to *1.90* ft., Dia *7* in. to _____ ft.
 Casing height above land surface *24* in., weight _____ lbs./ft. Wall thickness or gauge No. _____

TYPE OF SCREEN OR PERFORATION MATERIAL: 7 PVC 10 Asbestos-cement
 1 Steel 3 Stainless steel 5 Fiberglass 8 RMP (SR) 11 Other (specify) *Styrene*
 2 Brass 4 Galvanized steel 6 Concrete tile 9 ABS 12 None used (open hole)

SCREEN OR PERFORATION OPENINGS ARE: 5 Gauzed wrapped 8 Saw cut 11 None (open hole)
 1 Continuous slot ③ Mill slot 6 Wire wrapped 9 Drilled holes
 2 Louvered shutter 4 Key punched 7 Torch cut 10 Other (specify) _____

SCREEN-PERFORATED INTERVALS: From *1.90* ft. to *7.90 2.25* ft., From _____ ft. to _____ ft.
 From _____ ft. to _____ ft., From _____ ft. to _____ ft.

GRAVEL PACK INTERVALS: From _____ ft. to _____ ft., From _____ ft. to _____ ft.
 From _____ ft. to _____ ft., From _____ ft. to _____ ft.

6 GROUT MATERIAL: 1 Neat cement 2 Cement grout 3 Bentonite 4 Other _____
 Grout intervals: From _____ ft. to _____ ft., From _____ ft. to _____ ft., From _____ ft. to _____ ft.

What is the nearest source of possible contamination: 10 Livestock pens 14 Abandoned water well
 1 Septic tank 4 Lateral lines 7 Pit privy 11 Fuel storage 15 Oil well/Gas well
 2 Sewer lines 5 Cess pool 8 Sewage lagoon 12 Fertilizer storage 16 Other (specify below)
 3 Watertight sewer lines 6 Seepage pit 9 Feedyard 13 Insecticide storage _____

Direction from well? _____ How many feet? _____

| FROM | TO | LITHOLOGIC LOG | FROM | TO | PLUGGING INTERVALS |
|------|----|--|------|----|--------------------|
| | | <i>The well was cased with steel casing I cleared shale out from 1.90 on put 5" styrene casing in.</i> | | | |

7 CONTRACTOR'S OR LANDOWNER'S CERTIFICATION: This water well was (1) constructed, (2) reconstructed, or (3) plugged under my jurisdiction and was completed on (mo/day/year) *7-19-89* and this record is true to the best of my knowledge and belief. Kansas Water Well Contractor's License No. *486* This Water Well Record was completed on (mo/day/yr) *7-21-89* under the business name of *Edgar Swank well Drilling* by (signature) *Edgar Swank*

OFFICE USE ONLY

T

R

EW

SEC

1/4

1/4

1/4