


1 LOCATION OF WATER WELL: County: Osage Fraction: SW 1/4 SW 1/4 SW 1/4 Section Number: 10 Township Number: T 17 S Range Number: R 17 EW

Distance and direction from nearest town or city street address of well if located within city?
In Queremo, Ks.

2 WATER WELL OWNER: Sandy Lewis
RR#, St. Address, Box #: 110 N. 4th.
City, State, ZIP Code: Queremo, Ks. 66528
Board of Agriculture, Division of Water Resources
Application Number: _____

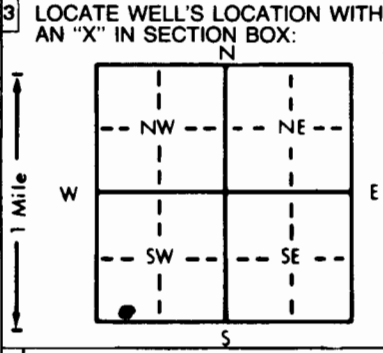

4 DEPTH OF COMPLETED WELL: 25' ft. ELEVATION: _____ ft.
Depth(s) Groundwater Encountered 1. 18' ft. 2. _____ ft. 3. _____ ft.
WELL'S STATIC WATER LEVEL: 12'6" ft. below land surface measured on mo/day/yr 11-3-93
Pump test data: Well water was _____ ft. after _____ hours pumping _____ gpm
Est. Yield _____ gpm; Well water was _____ ft. after _____ hours pumping _____ gpm
Bore Hole Diameter: 7 1/2" in. to 25' ft., and _____ in. to _____ ft.
WELL WATER TO BE USED AS:
5 Public water supply 8 Air conditioning 11 Injection well
1 Domestic 3 Feedlot 6 Oil field water supply 9 Dewatering 12 Other (Specify below)
2 Irrigation 4 Industrial 7 Lawn and garden only Monitoring well
Was a chemical/bacteriological sample submitted to Department? Yes _____ No ; If yes, mo/day/yr sample was submitted _____
Water Well Disinfected? Yes _____ No

5 TYPE OF BLANK CASING USED:
1 Steel 3 RMP (SR) 5 Wrought iron 8 Concrete tile CASING JOINTS: Glued _____ Clamped _____
 2 PVC 4 ABS 6 Asbestos-Cement 9 Other (specify below) Welded _____
Blank casing diameter: 2.42 in. to 10' ft., Dia _____ in. to _____ ft., Dia _____ in. to _____ ft.
Casing height above land surface: 3' Above ground in., weight _____ lbs./ft. Wall thickness or gauge No. SDR-13 SCH 40
TYPE OF SCREEN OR PERFORATION MATERIAL:
1 Steel 3 Stainless steel 5 Fiberglass 8 RMP (SR) 10 Asbestos-cement SCH 40
2 Brass 4 Galvanized steel 6 Concrete tile 9 ABS 12 None used (open hole)
SCREEN OR PERFORATION OPENINGS ARE:
1 Continuous slot 3 Mill slot 5 Gauzed wrapped 8 Saw cut 11 None (open hole)
2 Louvered shutter 4 Key punched 6 Wire wrapped 9 Drilled holes
3 Torch cut 10 Other (specify) _____
SCREEN-PERFORATED INTERVALS: From _____ ft. to _____ ft., From _____ ft. to _____ ft.
GRAVEL PACK INTERVALS: From _____ ft. to _____ ft., From _____ ft. to _____ ft.

6 GROUT MATERIAL:
Grout Intervals: From 8'1/2' ft. to 4' ft., From 4' ft. to 0' ft., From _____ ft. to _____ ft.
What is the nearest source of possible contamination:
1 Septic tank 4 Lateral lines 7 Pit privy 11 Fuel storage 14 Abandoned water well
2 Sewer lines 5 Cess pool 8 Sewage lagoon 12 Fertilizer storage 15 Oil well/Gas well
3 Watertight sewer lines 6 Seepage pit 9 Feedyard 13 Insecticide storage 16 Other (specify below) _____
Direction from well? West North West How many feet? 250'

FROM	TO	LITHOLOGIC LOG	FROM	TO	PLUGGING INTERVALS
0	2.5	Brown gravelly fill, bricks, concrete			
2.5	17.5	Med. Gray Brown to Brown clay, mottled iron oxide stained, dk brown lamination			
17.5	20.0	Red Brown silty clay w/ heavy mottling iron oxides			
20.0	25.0	Brown silty clay to clayey silt w/ fine-med grained sand (sand len at 20'), iron oxides			

7 CONTRACTOR'S OR LANDOWNER'S CERTIFICATION: This water well was (1) constructed, (2) reconstructed, or (3) plugged under my jurisdiction and was completed on (mo/day/year) 11-3-93 and this record is true to the best of my knowledge and belief. Kansas Water Well Contractor's License No. 539 This Water Well Record was completed on (mo/day/yr) 11-5-93 under the business name of GB Environmental Drilling by (signature) James Bieker