


1 LOCATION OF WATER WELL: County: Osage Fraction: SW 1/4 SW 1/4 SW 1/4 Section Number: 10 Township Number: T 17 S Range Number: R 17 EW

Distance and direction from nearest town or city street address of well if located within city?

In Quenemo

2 WATER WELL OWNER: Sandy Lewis Site: 110 N. 4th. Board of Agriculture, Division of Water Resources
 RR#, St. Address, Box #: Rt 1 City, State, ZIP Code: Quenemo, Ks Quenemo Application Number:

3 LOCATE WELL'S LOCATION WITH AN "X" IN SECTION BOX: 4 DEPTH OF COMPLETED WELL: 25ft. ft. ELEVATION:

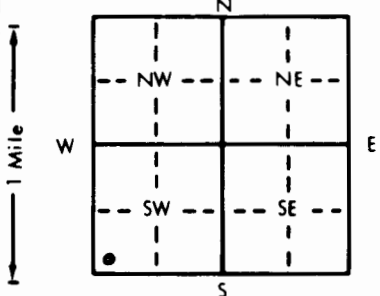

Depth(s) Groundwater Encountered 1. 17' ft. 2. ft. 3. ft.
 WELL'S STATIC WATER LEVEL 12' ft. below land surface measured on mo/day/yr 8-3-93
 Pump test data: Well water was ft. after hours pumping gpm
 Est. Yield +2 gpm Well water was ft. after hours pumping gpm
 Bore Hole Diameter 7 1/2" in. to 25' ft., and in. to ft.
 WELL WATER TO BE USED AS: 5 Public water supply 8 Air conditioning 11 Injection well
 1 Domestic 3 Feedlot 6 Oil field water supply 9 Dewatering 12 Other (Specify below)
 2 Irrigation 4 Industrial 7 Lawn and garden only 10 Monitoring well
 Was a chemical/bacteriological sample submitted to Department? Yes No X; If yes, mo/day/yr sample was submitted
 Water Well Disinfected? Yes No

5 TYPE OF BLANK CASING USED: 1 Steel 3 RMP (SR) 5 Wrought iron 8 Concrete tile CASING JOINTS: Glued Clamped
2 PVC 4 ABS 6 Asbestos-Cement 9 Other (specify below) Welded
 7 Fiberglass Threaded X

Blank casing diameter 2.42 in. to 15' ft., Dia in. to ft., Dia in. to ft.
 Casing height above land surface Flush Mount in., weight lbs./ft. Wall thickness or gauge No. SDR-13 Sch 40

TYPE OF SCREEN OR PERFORATION MATERIAL: 7 PVC 10 Asbestos-cement
 1 Steel 3 Stainless steel 5 Fiberglass 8 RMP (SR) 11 Other (specify)
 2 Brass 4 Galvanized steel 6 Concrete tile 9 ABS 12 None used (open hole)

SCREEN OR PERFORATION OPENINGS ARE: 5 Gauzed wrapped 8 Saw cut 11 None (open hole)
 1 Continuous slot Mill slot .010 6 Wire wrapped 9 Drilled holes
 2 Louvered shutter 4 Key punched 7 Torch cut 10 Other (specify)

SCREEN-PERFORATED INTERVALS: From 25' ft. to 15' ft., From ft. to ft.
 From ft. to ft., From ft. to ft.
 GRAVEL PACK INTERVALS: From 25' ft. to 13' ft., From ft. to ft.
 From ft. to ft., From ft. to ft.

6 GROUT MATERIAL: 1 Neat cement 2 Cement grout 3 Bentonite 4 Other
 Grout Intervals: From 13' (3) to 4' ft., From 4' (2) Surface ft., From ft. to ft.

What is the nearest source of possible contamination:
 1 Septic tank 4 Lateral lines 7 Pit privy 11 Fuel storage 14 Abandoned water well
 2 Sewer lines 5 Cess pool 8 Sewage lagoon 12 Fertilizer storage 15 Oil well/Gas well
 3 Watertight sewer lines 6 Seepage pit 9 Feedyard 13 Insecticide storage 16 Other (specify below)

Direction from well? Northwest How many feet? 50'

FROM	TO	LITHOLOGIC LOG	FROM	TO	PLUGGING INTERVALS
0	1.75	ls. Rx. gravel			
1.75	4.0	dk. brown to black silty clay			
4.0	8.5	Med Gray silty clay w/ iron oxide staining			
8.5	13.5	Red Brown silty clay w/ Gray silty clay mottling			
13.5	18.75	Blue-Gray brown silty clay, iron oxide staining			
18.75	25.0	Blue Gray silt, wet, dk Black banding			

7 CONTRACTOR'S OR LANDOWNER'S CERTIFICATION: This water well was (1) constructed, (2) reconstructed, or (3) plugged under my jurisdiction and was completed on (mo/day/year) 8-3-93 and this record is true to the best of my knowledge and belief. Kansas Water Well Contractor's License No. 539 This Water Well Record was completed on (mo/day/yr) 8-16-93 under the business name of JB Environmental Drilling by (signature) James Bieker