


1 LOCATION OF WATER WELL: County: Osage Fraction: SW 1/4 SW 1/4 SW 1/4 Section Number: 10 Township Number: T 17 S Range Number: R 17 EW

Distance and direction from nearest town or city street address of well if located within city?
In Quenemo

2 WATER WELL OWNER: Sandy Lewis (Ret) home address
 RR#, St. Address, Box #: 110N 4th Board of Agriculture, Division of Water Resources
 City, State, ZIP Code: Quenemo, Ks. Application Number:

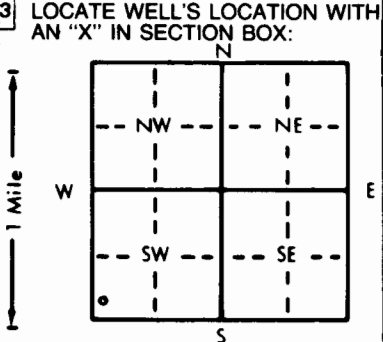

4 DEPTH OF COMPLETED WELL: 30ft ft. ELEVATION: ft.
 Depth(s) Groundwater Encountered 1. 18ft ft. 2. ft. 3. ft.
 WELL'S STATIC WATER LEVEL: 12.5 ft. below land surface measured on mo/day/yr 8-3-93
 Pump test data: Well water was ft. after hours pumping gpm
 Est. Yield: ±2 gpm: Well water was ft. after hours pumping gpm
 Bore Hole Diameter: 7.12 in. to 30ft ft., and in. to ft.
 WELL WATER TO BE USED AS:
 5 Public water supply 8 Air conditioning 11 Injection well
 1 Domestic 3 Feedlot 6 Oil field water supply 9 Dewatering 12 Other (Specify below)
 2 Irrigation 4 Industrial 7 Lawn and garden only 10 Monitoring well
 Was a chemical/bacteriological sample submitted to Department? Yes No X; If yes, mo/day/yr sample was submitted
 Water Well Disinfected? Yes No X

5 TYPE OF BLANK CASING USED:
 1 Steel 3 RMP (SR) 5 Wrought iron 8 Concrete tile CASING JOINTS: Glued Clamped
2 PVC 4 ABS 6 Asbestos-Cement 9 Other (specify below) Welded
 7 Fiberglass Threaded X
 Blank casing diameter: 2.42 in. to 15ft ft., Dia in. to ft., Dia in. to ft.
 Casing height above land surface: Flush Mount in., weight lbs./ft. Wall thickness or gauge No. SDR-13
 TYPE OF SCREEN OR PERFORATION MATERIAL:
 1 Steel 3 Stainless steel 5 Fiberglass 7 PVC 10 Asbestos-cement Sch 40
 2 Brass 4 Galvanized steel 6 Concrete tile 9 ABS 11 Other (specify)
 12 None used (open hole)
 SCREEN OR PERFORATION OPENINGS ARE:
 1 Continuous slot 3 Mill slot .010 5 Gauzed wrapped 8 Saw cut 11 None (open hole)
 2 Louvered shutter 4 Key punched 6 Wire wrapped 9 Drilled holes
 7 Torch cut 10 Other (specify)
 SCREEN-PERFORATED INTERVALS: From 30 ft. to 15 ft., From ft. to ft.
 From ft. to ft., From ft. to ft.
 GRAVEL PACK INTERVALS: From 30ft ft. to 13ft ft., From ft. to ft.
 From ft. to ft., From ft. to ft.

6 GROUT MATERIAL: 1 Neat cement 2 Cement grout 3 Bentonite 4 Other
 Grout Intervals: From 13' ft. to 3' ft., From 3' ft. to Surface ft., From ft. to ft.
 What is the nearest source of possible contamination:
 1 Septic tank 4 Lateral lines 7 Pit privy 11 Fuel storage 14 Abandoned water well
 2 Sewer lines 5 Cess pool 8 Sewage lagoon 12 Fertilizer storage 15 Oil well/Gas well
 3 Watertight sewer lines 6 Seepage pit 9 Feedyard 13 Insecticide storage 16 Other (specify below)
 Direction from well? South South West How many feet? 125ft

FROM	TO	LITHOLOGIC LOG	FROM	TO	PLUGGING INTERVALS
0	4.0	DK Brown silty clay, tree roots			
4.0	9.5	DK Grey to Gray silty clay, iron oxide staining			
9.5	17.5	Red Brown silty clay, w fine gray silty mottling			
17.5	25.0	Red Brown silt			
25.0	30.0	Red Brown sandy silt			

7 CONTRACTOR'S OR LANDOWNER'S CERTIFICATION: This water well was (1) constructed (2) reconstructed, or (3) plugged under my jurisdiction and was completed on (mo/day/year) 8-3-93 and this record is true to the best of my knowledge and belief. Kansas Water Well Contractor's License No. 539 This Water Well Record was completed on (mo/day/yr) 8-16-93 under the business name of JB Environmental Drilling by (signature) James Becker

OFFICE USE ONLY

T

R

EW

SEC.

1/4

1/4

1/4