


1 LOCATION OF WATER WELL: Fraction SW 1/4 NE 1/4 NE 1/4 Section Number 32 Township Number T 17 S Range Number R 17 **EW**
 County: OSAGE

Distance and direction from nearest town or city street address of well if located within city?
 3 1/2 south, 1 1/4 west of Quenemo

2 WATER WELL OWNER: Donna Rose
 RR#, St. Address, Box #: 22192 W. 223rd Breuer job Board of Agriculture, Division of Water Resources
 City, State, ZIP Code: Springhill, KS 66083 Application Number:

3 LOCATE WELL'S LOCATION WITH AN "X" IN SECTION BOX:

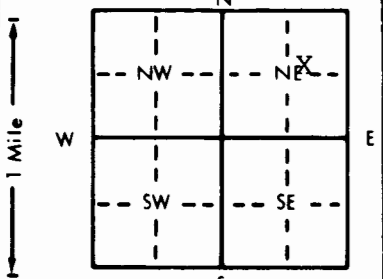

4 DEPTH OF COMPLETED WELL... 150' ft. ELEVATION:
 Depth(s) Groundwater Encountered 1. 116' ft. 2. ft. 3. ft.
 WELL'S STATIC WATER LEVEL... 81' ft. below land surface measured on mo/day/yr 4-19-95
 Pump test data: Well water was ft. after hours pumping gpm
 Est. Yield 5 gpm: Well water was ft. after hours pumping gpm
 Bore Hole Diameter 8 3/4 in. to ft. and in. to ft.
 WELL WATER TO BE USED AS: 5 Public water supply 8 Air conditioning 11 Injection well
 1 Domestic 3 Feedlot 6 Oil field water supply 9 Dewatering 12 Other (Specify below)
 2 Irrigation 4 Industrial 7 Lawn and garden only 10 Monitoring well
 Was a chemical/bacteriological sample submitted to Department? Yes No **X**; If yes, mo/day/yr sample was submitted Water Well Disinfected? Yes **X** No

5 TYPE OF BLANK CASING USED: 5 Wrought iron 8 Concrete tile CASING JOINTS: Glued **X** Clamped
 1 Steel 3 RMP (SR) 6 Asbestos-Cement 9 Other (specify below) Welded
 2 PVC 4 ABS 7 Fiberglass Threaded

Blank casing diameter 5 in. to 0-100 ft., Dia 5 in. to 140-150 ft., Dia in. to ft.
 Casing height above land surface 24 in., weight 2.82 lbs./ft. Wall thickness or gauge No. 258

TYPE OF SCREEN OR PERFORATION MATERIAL: 7 PVC 10 Asbestos-cement
 1 Steel 3 Stainless steel 5 Fiberglass 8 RMP (SR) 11 Other (specify)
 2 Brass 4 Galvanized steel 6 Concrete tile 9 ABS 12 None used (open hole)

SCREEN OR PERFORATION OPENINGS ARE: 5 Gauzed wrapped 8 Saw cut 11 None (open hole)
 1 Continuous slot 3 Mill slot 6 Wire wrapped 9 Drilled holes
 2 Louvered shutter 4 Key punched 7 Torch cut 10 Other (specify)

SCREEN-PERFORATED INTERVALS: From 100 ft. to 140 ft., From ft. to ft.
 GRAVEL PACK INTERVALS: From 24 ft. to 150 ft., From ft. to ft.

6 GROUT MATERIAL: 1 Neat cement 2 Cement grout 3 Bentonite 4 Other
 Grout Intervals: From 4 ft. to 24 ft., From ft. to ft., From ft. to ft.

What is the nearest source of possible contamination:
 1 Septic tank 4 Lateral lines 7 Pit privy 10 Livestock pens 14 Abandoned water well
 2 Sewer lines 5 Cess pool 8 Sewage lagoon 11 Fuel storage 15 Oil well/Gas well
 3 Watertight sewer lines 6 Seepage pit 9 Feedyard 12 Fertilizer storage 16 Other (specify below)
 13 Insecticide storage
 Direction from well? north How many feet? 300'

FROM	TO	LITHOLOGIC LOG	FROM	TO	PLUGGING INTERVALS
0	3	Clay-Brown	68	70	Shale-Black
3	4	Shale-Yellow	70	90	Shale-Grey
4	5	Limestone-Yellow	90	100	Sandy Shale-Grey
5	9	Shale-Yellow	100	116	Sandstone-Grey (5 GPM)
9	24	Limestone-Yellow	116	117	Shale-Grey
24	26	Shale-Black	117	119	Sandstone-Grey
26	37	Shaley Limestone-Grey	119	121	Shale-Grey
37	39	Limestone-Grey	121	130	Sandstone-Grey
39	41	Shale-Grey	130	133	Shale-Grey
41	43	Limestone-Grey	133	136	Sandstone-Grey
43	44	Shale-Grey	136	143	Limestone-Grey
44	55	Sandstone-Grey	143	150	Shale-Grey
55	56	Limestone-Grey			
56	61	Shale-Grey			
61	68	Shaley Limestone-Grey			

7 CONTRACTOR'S OR LANDOWNER'S CERTIFICATION: This water well was (1) constructed, (2) reconstructed, or (3) plugged under my jurisdiction and was completed on (mo/day/year) 4-19-95 and this record is true to the best of my knowledge and belief. Kansas Water Well Contractor's License No. 182 This Water Well Record was completed on (mo/day/yr) 5-5-95 under the business name of STRADER DRILLING CO., INC. by (signature) Dale Jackson

INSTRUCTIONS: Use typewriter or ball point pen. PLEASE PRESS FIRMLY and PRINT clearly. Please fill in blanks, underline or circle the correct answers. Send top three copies to Kansas Department of Health and Environment, Bureau of Water, Topeka, Kansas 66620-0001. Telephone: 913-296-5545. Send one to WATER WELL OWNER and retain one for your records.