


1 LOCATION OF WATER WELL: County: Franklin Fraction: NW 1/4 NE 1/4 SW 1/4 Section Number: 12 Township Number: T 17 S Range Number: R 18 EW
 Distance and direction from nearest town or city street address of well if located within city? 4.2 East and 1.6 South of Pomona, KS.

2 WATER WELL OWNER: David Buehler
 RR#, St. Address, Box #: 1533 Labette Rd Board of Agriculture, Division of Water Resources
 City, State, ZIP Code: Ottawa, Kansas 66067 Application Number:

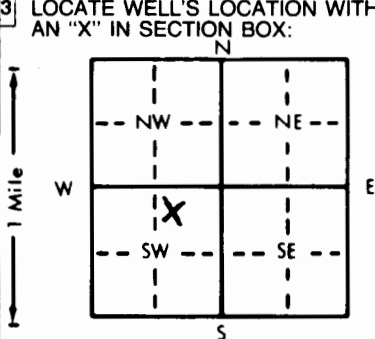

4 DEPTH OF COMPLETED WELL: 140 ft. ELEVATION:
 Depth(s) Groundwater Encountered 1. 98-140 ft. 2. ft. 3. ft.
 WELL'S STATIC WATER LEVEL 52 ft. below land surface measured on mo/day/yr 4-8-96
 Pump test data: Well water was ft. after hours pumping gpm
 Est. Yield 6 gpm; Well water was ft. after hours pumping gpm
 Bore Hole Diameter: 8 3/4 in. to 20 ft., and 7 7/8 in. to 140 ft.
 WELL WATER TO BE USED AS:
 1 Domestic 3 Feedlot 6 Oil field water supply 9 Dewatering 12 Other (Specify below)
 2 Irrigation 4 Industrial 7 Lawn and garden only 10 Monitoring well
 Was a chemical/bacteriological sample submitted to Department? Yes.....No; If yes, mo/day/yr sample was submitted
 Water Well Disinfected? Yes No

5 TYPE OF BLANK CASING USED:
 1 Steel 3 RMP (SR) 5 Wrought iron 8 Concrete tile CASING JOINTS: Glued Clamped
 2 PVC 4 ABS 6 Asbestos-Cement 9 Other (specify below) Welded
 7 Fiberglass Threaded
 Blank casing diameter 5 in. to 130 ft. Dia. in. to ft. Dia. in. to ft.
 Casing height above land surface 36 in., weight 200 PSI lbs./ft. Wall thickness or gauge No.
 TYPE OF SCREEN OR PERFORATION MATERIAL:
 1 Steel 3 Stainless steel 5 Fiberglass 7 PVC 10 Asbestos-cement
 2 Brass 4 Galvanized steel 6 Concrete tile 9 ABS 11 Other (specify)
 12 None used (open hole)
 SCREEN OR PERFORATION OPENINGS ARE:
 1 Continuous slot 3 Mill slot 5 Gauzed wrapped 8 Saw cut 11 None (open hole)
 2 Louvered shutter 4 Key punched 6 Wire wrapped 9 Drilled holes
 7 Torch cut 10 Other (specify)
 SCREEN-PERFORATED INTERVALS: From 130 ft. to 140 ft., From ft. to ft.
 From ft. to ft., From ft. to ft.
 GRAVEL PACK INTERVALS: From 140 ft. to 20 ft., From ft. to ft.
 From ft. to ft., From ft. to ft.

6 GROUT MATERIAL: 1 Neat cement 2 Cement grout 3 Bentonite 4 Other
 Grout Intervals: From D ft. to 20 ft., From ft. to ft., From ft. to ft.
 What is the nearest source of possible contamination: Soon to be plugged → 14 Abandoned water well
 1 Septic tank 4 Lateral lines 7 Pit privy 10 Livestock pens 15 Oil well/Gas well
 2 Sewer lines 5 Cess pool 8 Sewage lagoon 11 Fuel storage 16 Other (specify below)
 3 Watertight sewer lines 6 Seepage pit 9 Feedyard 12 Fertilizer storage 13 Insecticide storage
 Direction from well? E How many feet? 10

FROM	TO	LITHOLOGIC LOG	FROM	TO	PLUGGING INTERVALS
0	10	Soil & Clay			
10	41	SAND - Brown			
41	98	SAND, Grey			
98	120	SAND - Light Grey, Fine			
120	123	SANDY Lime			
123	130	SAND, Grey, fine			
130	134	SANDY Lime			
134	140	SAND, Grey, Coarse			
140		Lime			

7 CONTRACTOR'S OR LANDOWNER'S CERTIFICATION: This water well was (1) constructed, (2) reconstructed, or (3) plugged under my jurisdiction and was completed on (mo/day/year) 4-8-96 and this record is true to the best of my knowledge and belief. Kansas
 Water Well Contractor's License No. 561 This Water Well Record was completed on (mo/day/yr) 4-9-96
 under the business name of EVANS ENERGY Dev. Inc. by (signature) Scott E.

INSTRUCTIONS: Use typewriter or ball point pen. PLEASE PRESS FIRMLY and PRINT clearly. Please fill in blanks, underline or circle the correct answers. Send top three copies to Kansas Department of Health and Environment, Bureau of Water, Topeka, Kansas 66620-0001. Telephone: 913-296-5545. Send one to WATER WELL OWNER and retain one for your records.