

USE TYPEWRITER OR BALL POINT PEN-PRESS FIRMLY, PRINT CLEARLY.


Well 2

WATER WELL RECORD
KSA 82a-1201-1215

Kansas Department of Health and Environment-Division of Environment (Water well Contractors) Topeka, Kansas 66620

1. Location of well: County Franklin Fraction NW 1/4 NW 1/4 NW 1/4 Section number 4 Township number T 17 Range number S R 18 E/W

2. Distance and direction from nearest town or city: 1 MI EAST 3. Owner of well: Edgar Swank
Street address of well location if in city: Pomona R.R. or street: RR
City, state, zip code: Pomona, Kansas 66076

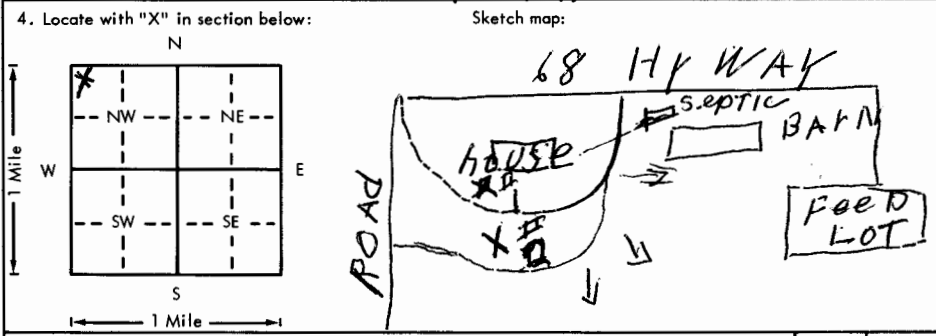

6. Bore hole dia. 6 1/4 in. Completion date 11-22-76
Well depth 135 ft. 9' 10 1/2'

7. Cable tool Rotary Driven Dug
 Hollow rod Jetted Bored Reverse rotary

8. Use: Domestic Public supply Industry
 Irrigation Air conditioning Stock
 Lawn Oil field water Other

5. Type and color of material

| | From | To |
|------------------|------|-----|
| Soil | 0 | 1 |
| Clay | 1 | 25 |
| Yellow Sand/loam | 25 | 70 |
| Grey Shale | 70 | 100 |
| Grey Sand | 100 | 135 |

10. Screen: Manufacturer's name NONE
Type _____ Dia. _____
Slot/gauze _____ Length _____
Set between _____ ft. and _____ ft.
_____ ft. and _____ ft.
Gravel pack? _____ Size range of material _____

11. Static water level: _____ mo./day/yr.
60 ft. below land surface Date 11-12-76

12. Pumping level below land surfaces:
_____ ft. after _____ hrs. pumping _____ g.p.m.
_____ ft. after _____ hrs. pumping _____ g.p.m.
Estimated maximum yield BETTER THAN 40 g.p.m.

13. Water sample submitted: _____ mo./day/yr.
Yes No Date _____

14. Well head completion:
 Pitless adapter 24 Inches above grade

15. Well grouted?
With: Neat cement Bentonite Concrete
Depth: From 0 ft. to 18 ft.

16. Nearest source of possible contamination:
ft. 200 Direction E Type SEPTIC
Well disinfected upon completion? Yes No

17. Pump:
Manufacturer's name 40' R 20 JACKET Not installed
Model number 100N1 HP 1/2 Volts 220
Length of drop pipe 120' ft. capacity 10 g.p.m.
Type:
 Submersible Turbine
 Jet Reciprocating
 Centrifugal Other

Well #1 was Drilled in 1965

(Use a second sheet if needed)

18. Elevation: _____

19. Remarks: Cement Slap will be poured as soon as ground settles and is warm enough

20. Water well contractor's certification:
This well was drilled under my jurisdiction and this report is true to the best of my knowledge and belief.
EDGAR SWANK 124
Business name _____ License No. _____
Address OTTAWA KAN R4
Signed Edgar Swank Date 12-30-76
Authorized representative

T 17 R 18 E/W 4 NW 1/4 NW 1/4