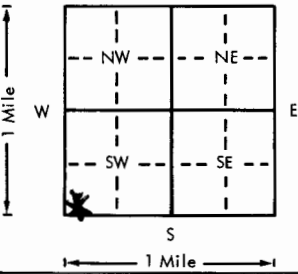
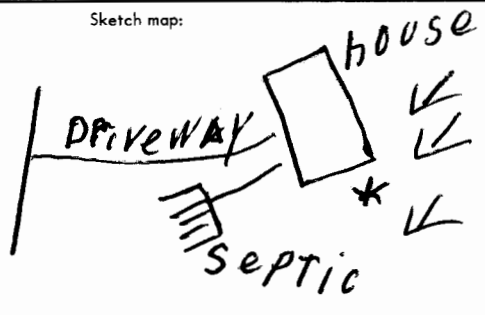


USE TYPEWRITER OR BALL  
POINT PEN-PRESS FIRMLY,  
PRINT CLEARLY.

WATER WELL RECORD  
KSA 82a-1201-1215

Kansas Department of Health and  
Environment-Division of Environment  
(Water well Contractors)  
Topeka, Kansas 66620

1. Location of well:		County <b>Franklin</b>	Fraction <b>SW 1/4 SW 1/4 SW 1/4</b>	Section number <b>8</b>	Township number <b>T 17 S</b>	Range number <b>R 18 E/W</b>
2. Distance and direction from nearest town or city: <b>3mi. south</b>			3. Owner of well: <b>Doug combs</b>			
Street address of well location if in city: <b>Pomona</b>			R.R. or street: <b>RR1</b>			
			City, state, zip code: <b>Pomona Kans. 66076</b>			
4. Locate with "X" in section below:		Sketch map:		6. Bore hole dia. <b>6 1/2</b> in. Completion date <b>3-28-78</b>		
				Well depth <b>140</b> ft. <b>9" to 18"</b>		
5. Type and color of material		From		To		7. <input checked="" type="checkbox"/> Cable tool <input type="checkbox"/> Rotary <input type="checkbox"/> Driven <input type="checkbox"/> Dug
						<input type="checkbox"/> Hollow rod <input type="checkbox"/> Jetted <input type="checkbox"/> Bored <input type="checkbox"/> Reverse rotary
						8. Use: <input checked="" type="checkbox"/> Domestic <input type="checkbox"/> Public supply <input type="checkbox"/> Industry
						<input type="checkbox"/> Irrigation <input type="checkbox"/> Air conditioning <input type="checkbox"/> Stock
						<input type="checkbox"/> Lawn <input type="checkbox"/> Oil field water <input type="checkbox"/> Other
9. Casing: Material <input type="checkbox"/> Height: Above <input type="checkbox"/> Below <input type="checkbox"/>		Threaded <input type="checkbox"/> Welded <input type="checkbox"/> Surface <b>24</b> in.				
RMP <input type="checkbox"/> PVC <input checked="" type="checkbox"/> Weight <b>56</b> lbs./ft.		Dia. <b>6 1/2</b> in. to <b>20</b> ft. depth				
Wall thickness: inches or		Dia. <input type="checkbox"/> in. to <input type="checkbox"/> ft. depth				
gauge No. <b>56</b>		10. Screen: Manufacturer's name <input type="checkbox"/>				
Type <input type="checkbox"/> Dia. <input type="checkbox"/>		Slot/gauze <input type="checkbox"/> Length <input type="checkbox"/>				
Set between <input type="checkbox"/> ft. and <input type="checkbox"/> ft.		Gravel pack? <input type="checkbox"/> Size range of material <input type="checkbox"/>				
11. Static water level: <input type="checkbox"/> mo./day/yr.		<b>75</b> ft. below land surface Date <input type="checkbox"/>				
12. Pumping level below land surfaces:		<input type="checkbox"/> ft. after <input type="checkbox"/> hrs. pumping <input type="checkbox"/> g.p.m.				
<input type="checkbox"/> ft. after <input type="checkbox"/> hrs. pumping <input type="checkbox"/> g.p.m.		Estimated maximum yield <b>7</b> g.p.m.				
13. Water sample submitted: <input type="checkbox"/> mo./day/yr.		Yes <input type="checkbox"/> No <input type="checkbox"/> Date <input type="checkbox"/>				
14. Well head completion:		<input checked="" type="checkbox"/> Pitless adapter <b>24</b> inches above grade				
15. Well grouted? <input checked="" type="checkbox"/>		With: <input checked="" type="checkbox"/> Neat cement <input type="checkbox"/> Bentonite <input type="checkbox"/> Concrete				
Depth: From <b>03</b> ft. to <b>18</b> ft.		16. Nearest source of possible contamination:				
ft. <b>100</b> Direction <b>W</b> Type <b>septic</b>		Well disinfected upon completion? <input checked="" type="checkbox"/> Yes <input type="checkbox"/> No				
17. Pump:		Not installed				
Manufacturer's name <b>Red Jacket</b>		Model number <b>50N1-906</b> Volts <b>220</b>				
Length of drop pipe <b>130</b> ft. capacity <b>10</b> g.p.m.		Type:				
<input checked="" type="checkbox"/> Submersible <input type="checkbox"/> Turbine		<input type="checkbox"/> Jet <input type="checkbox"/> Reciprocating				
<input type="checkbox"/> Centrifugal <input type="checkbox"/> Other		20. Water well contractor's certification:				
18. Elevation:		This well was drilled under my jurisdiction and this report is true to the best of my knowledge and belief.				
19. Remarks:		<b>EDGAR SWANK 134</b>				
Topography:		Business name <b>OTTAWA KAN.</b> License No. <input type="checkbox"/>				
<input type="checkbox"/> Hill <input checked="" type="checkbox"/> Slope <input type="checkbox"/> Upland <input type="checkbox"/> Valley		Address <b>Edgar Swank</b> Date <b>3/78</b>				
		Signed <b>Edgar Swank</b> Authorized representative				