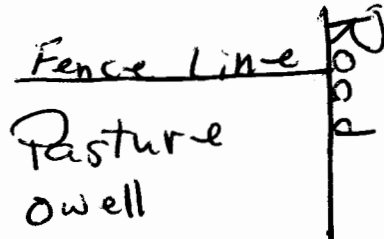


USE TYPEWRITER OR BALL POINT PEN-PRESS FIRMLY, PRINT CLEARLY.

WATER WELL RECORD
KSA 82a-1201-1215

Kansas Department of Health and Environment-Division of Environment
(Water well Contractors)
Topeka, Kansas 66620

1. Location of well:		County Franklin	Fraction NE¹/₄ NE¹/₄ SE¹/₄	Section number 11	Township number T 17 S R	Range number 18 E/W
2. Distance and direction from nearest town or city: Street address of well location if in city: Richter			3. Owner of well: Eugene H. Mark R.R. or street: RRL City, state, zip code: Pomona, Kan. 66086			
4. Locate with "X" in section below: N W E S 1 Mile 1 Mile		Sketch map: 		6. Bore hole dia. 6 1/2 in. Completion date 11-6-78 Well depth 110 ft. 97020		
5. Type and color of material		From To		7. <input checked="" type="checkbox"/> Cable tool <input type="checkbox"/> Rotary <input type="checkbox"/> Driven <input type="checkbox"/> Dug <input type="checkbox"/> Hollow rod <input type="checkbox"/> Jetted <input type="checkbox"/> Bored <input type="checkbox"/> Reverse rotary		
				8. Use: <input type="checkbox"/> Domestic <input type="checkbox"/> Public supply <input type="checkbox"/> Industry <input type="checkbox"/> Irrigation <input type="checkbox"/> Air conditioning <input type="checkbox"/> Stock <input type="checkbox"/> Lawn <input type="checkbox"/> Oil field water <input type="checkbox"/> Other		
				9. Casing: Material _____ Height: Above or below surface _____ Threaded _____ Welded _____ Surface 18 in. RMP 6 1/2 PVC <input checked="" type="checkbox"/> Weight sch 40 lbs./ft. Dia. 6 1/2 in. to 20 ft. depth Wall Thickness: inches or Dia. _____ in. to _____ ft. depth gage No. sch 40		
				10. Screen: Manufacturer's name _____ none Type _____ Dia. _____ Slot/gauze _____ Length _____ Set between _____ ft. and _____ ft. _____ ft. and _____ ft. Gravel pack? no Size range of material _____		
				11. Static water level: _____ mg./day/yr. 51 ft. below land surface Date 11-6-78		
soil		0 3		12. Pumping level below land surfaces: _____ ft. after _____ hrs. pumping _____ g.p.m. _____ ft. after _____ hrs. pumping _____ g.p.m. Estimated maximum yield 12 g.p.m.		
yellow sand rock		3 35		13. Water sample submitted: _____ mo./day/yr. Yes _____ No _____ Date _____		
grey sanded shale		35 67		14. Well head completion pump house _____ Pitless adapter _____ Inches above grade		
grey sand		67 110		15. Well grouted? _____ With: <input checked="" type="checkbox"/> Neat cement _____ Bentonite _____ Concrete _____ Depth: From 0 ft. to 20 ft.		
				16. Nearest source of possible contamination: ft. _____ Direction _____ Type _____ Well disinfected upon completion? _____ Yes _____ No		
				17. Pump: _____ Not installed Manufacturer's name Red Jacket Model number 30N13C HP 1/2 Volts 220 Length of drop pipe _____ ft. capacity _____ g.p.m. Type: <input checked="" type="checkbox"/> Submersible _____ Turbine _____ Jet _____ Reciprocating _____ Centrifugal _____ Other		
18. Elevation:		19. Remarks: Drill in middle of pasture. No contamination as of yet or building.		20. Water well contractor's certification: This well was drilled under my jurisdiction and this report is true to the best of my knowledge and belief. Royce Swank XXXXX Drilling Business name _____ 371 License No. _____ Address RRL Ottawa Ks. Signed Royce Swank Date 12-15 Authorized representative		

17 180 11 1/4 1/4 1/4