


1 LOCATION OF WATER WELL: County: Franklin Fraction: SW 1/4 SE 1/4 SW 1/4 Section Number: 14 Township Number: T 17 S Range Number: R 18 EW

Distance and direction from nearest town or city street address of well if located within city?
2 1/2 Miles North of Homewood, 1 Mile West, 1 Mile North East into Location

2 WATER WELL OWNER: Charles Main
 RR#, St. Address, Box #: RR2 Box 74 Board of Agriculture, Division of Water Resources
 City, State, ZIP Code: Wellsville, Ks Application Number:

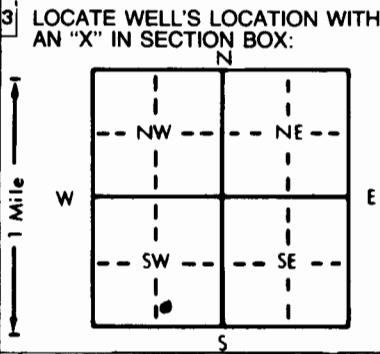

4 DEPTH OF COMPLETED WELL: 116 ft. ELEVATION:
 Depth(s) Groundwater Encountered 1. 64 ft. 2. ft. 3. ft.
 WELL'S STATIC WATER LEVEL 61 ft. below land surface measured on mo/day/yr 12/14/91
 Pump test data: Well water was ft. after hours pumping gpm
 Est. Yield 5-6 gpm: Well water was ft. after hours pumping gpm
 Bore Hole Diameter: 9" in. to 116 ft., and in. to ft.
 WELL WATER TO BE USED AS: 5 Public water supply 8 Air conditioning 11 Injection well
 1 Domestic 3 Feedlot 6 Oil field water supply 9 Dewatering 12 Other (Specify below)
 2 Irrigation 4 Industrial 7 Lawn and garden only 10 Monitoring well
 Was a chemical/bacteriological sample submitted to Department? Yes No; If yes, mo/day/yr sample was submitted
 Water Well Disinfected? Yes No

5 TYPE OF BLANK CASING USED: 5 Wrought iron 8 Concrete tile CASING JOINTS: Glued Clamped
 1 Steel 3 RMP (SR) 6 Asbestos-Cement 9 Other (specify below) Welded
 2 PVC 4 ABS 7 Fiberglass Threaded
 Blank casing diameter: 5.58 in. to 76 ft., Dia. in. to ft., Dia. in. to ft.
 Casing height above land surface: 18 inches in., weight lbs./ft. Wall thickness or gauge No. SDR-26
 TYPE OF SCREEN OR PERFORATION MATERIAL: 7 PVC 10 Asbestos-cement
 1 Steel 3 Stainless steel 5 Fiberglass 8 RMP (SR) 11 Other (specify)
 2 Brass 4 Galvanized steel 6 Concrete tile 9 ABS 12 None used (open hole)
 SCREEN OR PERFORATION OPENINGS ARE: 5 Gauzed wrapped 8 Saw cut 11 None (open hole)
 1 Continuous slot 3 Mill slot 6 Wire wrapped 9 Drilled holes
 2 Louvered shutter 4 Key punched 7 Torch cut 10 Other (specify)
 SCREEN-PERFORATED INTERVALS: From 116 ft. to 76 ft., From ft. to ft.
 From ft. to ft., From ft. to ft.
 GRAVEL PACK INTERVALS: From 116 ft. to 60 ft., From ft. to ft.
 From ft. to ft., From ft. to ft.

6 GROUT MATERIAL: 1 Neat cement 2 Cement grout 3 Bentonite 4 Other
 Grout Intervals: From 25 ft. to 6 ft. From 5 ft. to 0 ft., From ft. to ft.
 What is the nearest source of possible contamination: Bentonite Seal Cement Grout
 1 Septic tank 4 Lateral lines 7 Pit privy 10 Livestock pens 14 Abandoned water well
 2 Sewer lines 5 Cess pool 8 Sewage lagoon 11 Fuel storage 15 Oil well/Gas well
 3 Watertight sewer lines 6 Seepage pit 9 Feedyard 12 Fertilizer storage 16 Other (specify below)
 13 Insecticide storage (None) New Home site
 Direction from well? Southwest How many feet? 2,000ft

FROM	TO	LITHOLOGIC LOG	FROM	TO	PLUGGING INTERVALS
0	2	Brown top soil	91	92	Coal
2	10	Yellow Brown silty sandy clay	92	111	Gray sandstone "very fine grained"
10	26	Yellow Brown fine-med grained sandstone			
26	34	" " silty sandstone	111	116	Blue-gray shale
34	35	Coal Seam			
35	42	Yellow Brown silty sandstone			
42	48	Gray silty sandstone, fine-grained			
48	51 1/2	Gray sandy limestone "Hard"			
51 1/2	63	Greenish Clay shale			
63	64	Blue gray shale "calcareous"			
64	66	Blue gray sandstone "fine grained"			
66	68 1/2	Brown-Tan dense Limestone			
68 1/2	71	Blue gray shale			
71	79	Blue gray sandstone			
79	91	Blue-gray to Black shale			

7 CONTRACTOR'S OR LANDOWNER'S CERTIFICATION: This water well was (1) constructed, (2) reconstructed, or (3) plugged under my jurisdiction and was completed on (mo/day/year) 12/14/91 and this record is true to the best of my knowledge and belief. Kansas
 Water Well Contractor's License No. 539 This Water Well Record was completed on (mo/day/yr) 12/16/91
 under the business name of G. B. Environmental Drilling by signature James Bieber - Geologist

INSTRUCTIONS: Use typewriter or ball point pen. PLEASE PRESS FIRMLY and PRINT clearly. Please fill in blanks, underline or circle the correct answers. Send top three copies to Kansas Department of Health and Environment, Bureau of Water, Topeka, Kansas 66620-0001. Telephone: 913-296-5545. Send one to WATER WELL OWNER and retain one for your records.