


1 LOCATION OF WATER WELL: County: **FRANKLIN** Fraction: **SE 1/4 SW 1/4 SW 1/4** Section Number: **18** Township Number: **T 17 S** Range Number: **R 18 E/W**

Distance and direction from nearest town or city street address of well if located within city?
3 MILE South & 1/2 MILE WEST OF POMONA

2 WATER WELL OWNER: **RONALD BEER**
 RR#, St. Address, Box #: **875 EAST WILSON**
 City, State, ZIP Code: **STAWA, KS 66047**
 Board of Agriculture, Division of Water Resources
 Application Number:

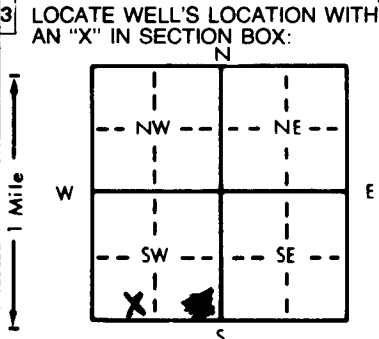

4 DEPTH OF COMPLETED WELL: **180** ft. ELEVATION:
 Depth(s) Groundwater Encountered 1. **135** ft. 2. ft. 3. ft.
 WELL'S STATIC WATER LEVEL: **135** ft. below land surface measured on mo/day/yr **7-3-91**
 Pump test data: Well water was ft. after hours pumping gpm
 Est. Yield **10** gpm: Well water was ft. after hours pumping gpm
 Bore Hole Diameter: **9** in. to **20** ft., and **6 3/4** in. to **180** ft.
 WELL WATER TO BE USED AS:
 1 Domestic 3 Feedlot 6 Oil field water supply 9 Dewatering 12 Other (Specify below)
 2 Irrigation 4 Industrial 7 Lawn and garden only 10 Monitoring well
 Was a chemical/bacteriological sample submitted to Department? Yes.....No.....**X**; If yes, mo/day/yr sample was submitted
 Water Well Disinfected? Yes **X** No

5 TYPE OF BLANK CASING USED:
 1 Steel 3 RMP (SR) 5 Wrought iron 8 Concrete tile CASING JOINTS: Glued **X** Clamped
 2 PVC 4 ABS 6 Asbestos-Cement 9 Other (specify below) Welded
 7 Fiberglass Threaded
 Blank casing diameter **5** in. to **140** ft., Dia. in. to ft., Dia. in. to ft.
 Casing height above land surface: **24"** in., weight lbs./ft. Wall thickness or gauge No. **302-26**
 TYPE OF SCREEN OR PERFORATION MATERIAL:
 1 Steel 3 Stainless steel 5 Fiberglass 7 PVC 10 Asbestos-cement
 2 Brass 4 Galvanized steel 6 Concrete tile 9 ABS 11 Other (specify)
 12 None used (open hole)
 SCREEN OR PERFORATION OPENINGS ARE:
 1 Continuous slot 3 Mill slot 5 Gauzed wrapped 8 Saw cut 11 None (open hole)
 2 Louvered shutter 4 Key punched 6 Wire wrapped 9 Drilled holes
 7 Torch cut 10 Other (specify)
 SCREEN-PERFORATED INTERVALS: From **140** ft. to **180** ft., From ft. to ft., From ft. to ft.
 GRAVEL PACK INTERVALS: From - ft. to - ft., From - ft. to - ft., From - ft. to - ft.

6 GROUT MATERIAL: 1 Neat cement 2 Cement grout 3 Bentonite 4 Other
 Grout Intervals: From **8** ft. to **38** ft., From ft. to ft., From ft. to ft., From ft. to ft.
 What is the nearest source of possible contamination:
 1 Septic tank 4 Lateral lines 7 Pit privy 10 Livestock pens 14 Abandoned water well
 2 Sewer lines 5 Cess pool 8 Sewage lagoon 11 Fuel storage 15 Oil well/Gas well
 3 Watertight sewer lines 6 Seepage pit 9 Feedyard 12 Fertilizer storage 16 Other (specify below)
 13 Insecticide storage
 Direction from well? **SOUTH** How many feet? **100**

FROM	TO	LITHOLOGIC LOG	FROM	TO	PLUGGING INTERVALS
0	6	SOIL			
6	17	SHALEY LIME			
17	27	SHALE			
27	30	LIME			
30	50	SHALE			
50	65	LIME			
65	67	COAL			
67	135	SANDY GREY SHALE			
135	180	GREY SAND STONE - LIME			

7 CONTRACTOR'S OR LANDOWNER'S CERTIFICATION: This water well was (1) constructed, (2) reconstructed, or (3) plugged under my jurisdiction and was completed on (mo/day/year) **7-3-91** and this record is true to the best of my knowledge and belief. Kansas Water Well Contractor's License No. **536** This Water Well Record was completed on (mo/day/yr) **7-8-91** under the business name of **Patchen Pump & Well Drilling Inc.** by (signature) **Jim E. Patchen**

OFFICE USE ONLY