


1 LOCATION OF WATER WELL: 030 Fraction SW 1/4 NE 1/4 NE 1/4 Section Number 20 Township Number T 17 S Range Number R 18 EW  
 County: FRANKLIN

Distance and direction from nearest town or city street address of well if located within city?  
2 1/2 S IE 1 MI. S POMONA KAN.

2 WATER WELL OWNER: DICK RICKSON  
 RR#, St. Address, Box #: RR 66876 Board of Agriculture, Division of Water Resources  
 City, State, ZIP Code: POMONA KAN Application Number:         

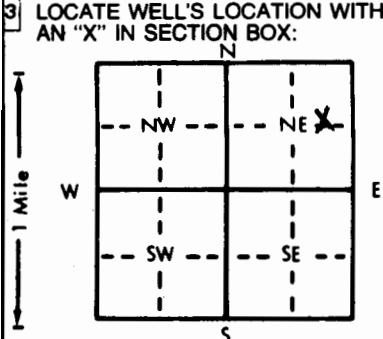

4 DEPTH OF COMPLETED WELL: 180 ft. ELEVATION:           
 Depth(s) Groundwater Encountered 1. 140 ft. 2.          ft. 3.          ft.  
 WELL'S STATIC WATER LEVEL 120 ft. below land surface measured on          mo/day/yr  
 Pump test data: Well water was          ft. after          hours pumping          gpm  
 Est. Yield 11 gpm: Well water was          ft. after          hours pumping          gpm  
 Bore Hole Diameter: 9 in. to 20 ft., and 6 1/4 in. to 180 ft.  
 WELL WATER TO BE USED AS:  
 5 Public water supply     8 Air conditioning     11 Injection well  
 1 Domestic     3 Feedlot     6 Oil field water supply     9 Dewatering     12 Other (Specify below)  
 2 Irrigation     4 Industrial     7 Lawn and garden only     10 Observation well  
 Was a chemical/bacteriological sample submitted to Department? Yes          No          If yes, mo/day/yr sample was submitted  
 Water Well Disinfected? Yes          No         

5 TYPE OF BLANK CASING USED:  
 1 Steel     3 RMP (SR)     5 Wrought iron     8 Concrete tile    CASING JOINTS: Glued          Clamped           
 2 PVC     4 ABS     6 Asbestos-Cement     9 Other (specify below)    Welded           
 Blank casing diameter 5 1/2 in. to          ft., Dia          in. to          ft., Dia          in. to          ft.  
 Casing height above land surface: 18 in., weight 5 ch 40 lbs./ft. Wall thickness or gauge No. 5 ch 40  
 TYPE OF SCREEN OR PERFORATION MATERIAL:  
 1 Steel     3 Stainless steel     5 Fiberglass     7 PVC     10 Asbestos-cement  
 2 Brass     4 Galvanized steel     6 Concrete tile     8 RMP (SR)     11 Other (specify)           
 12 None used (open hole)  
 SCREEN OR PERFORATION OPENINGS ARE:  
 1 Continuous slot     3 Mill slot     5 Gauzed wrapped     8 Saw cut     11 None (open hole)  
 2 Louvered shutter     4 Key punched     6 Wire wrapped     9 Drilled holes  
 7 Torch cut     10 Other (specify)           
 SCREEN-PERFORATED INTERVALS: From 160 ft. to 180 ft., From          ft. to          ft.  
 GRAVEL PACK INTERVALS: From          ft. to          ft., From          ft. to          ft.  
NONE

6 GROUT MATERIAL:  Neat cement     2 Cement grout     3 Bentonite     4 Other           
 Grout Intervals: From 5 ft. to 20 ft., From          ft. to          ft., From          ft. to          ft.  
 What is the nearest source of possible contamination:  
 1 Septic tank     4 Lateral lines     7 Pit privy     10 Livestock pens     14 Abandoned water well  
 2 Sewer lines     5 Cess pool     8 Sewage lagoon     11 Fuel storage     15 Oil well/Gas well  
 3 Watertight sewer lines     6 Seepage pit     9 Feedyard     12 Fertilizer storage     16 Other (specify below)  
 13 Insecticide storage  
 Direction from well? NORTH How many feet? 150

| FROM | TO  | LITHOLOGIC LOG      | FROM | TO | LITHOLOGIC LOG |
|------|-----|---------------------|------|----|----------------|
| 0    | 5   | 1 SOIL              |      |    |                |
| 5    | 8   | 20 SHELLY ROCK      |      |    |                |
| 8    | 15  | 19 SHALE            |      |    |                |
| 15   | 28  | 20 LIME             |      |    |                |
| 28   | 31  | 19 SHALE            |      |    |                |
| 31   | 59  | 20 LIME             |      |    |                |
| 59   | 123 | 19 SHALE            |      |    |                |
| 123  | 140 | 27 SANDY GREY SHALE |      |    |                |
| 140  | 150 | SAND                |      |    |                |
| 150  | 180 | 15 WHITE SAND       |      |    |                |

7 CONTRACTOR'S OR LANDOWNER'S CERTIFICATION: This water well was  constructed,  reconstructed, or  plugged under my jurisdiction and was completed on (mo/day/year) 4-20-88 and this record is true to the best of my knowledge and belief. Kansas Water Well Contractor's License No. 486 This Water Well Record was completed on (mo/day/yr) 4-20-88 under the business name of EDGAR SWANK DRILLING by (signature) Edgar Swank

INSTRUCTIONS: Use typewriter or ball point pen. PLEASE PRESS FIRMLY and PRINT clearly. Please fill in blanks, underline or circle the correct answers. Send top three copies to Kansas Department of Health and Environment, Bureau of Water Protection, Topeka, Kansas 66620-7320, Telephone: 913-862-9360. Send one to WATER WELL OWNER and retain one for your records.

OFFICE USE ONLY  
T 17  
R 18  
EW  
SEC. 20  
SW 1/4 NE 1/4 NE 1/4